

Late
A 2008
11-67

MISSISSIPPI
BOARD OF WATER COMMISSIONERS
416 North State Street
Jackson, Mississippi 39201

WATER WELL DRILLERS LOG

Nov 16 1967 Shelby Heyman Late
date well completed firm name county well located

LANDOWNER: Jayman Leuby
Arhatulla Miss

description of formations encountered	from	to
Red clay	0	20
gravel	20	24
White Sand	24	30
grey clay or Blue clay	30	90
Sand	90	100
Clear White Sand	100	112

(mailing address)


WELL LOCATION:
sec. 26 T. 4 N. R. 9 E. S. W.
1/2 miles N of Arhatulla
(distance) (direction) (nearest town)

WELL PURPOSE: Home
(home, irrigation, municipal, industrial)

WELL COMPLETION DATA:

- (1) diameter (inches) 2
- (2) total depth (feet) 112
- (3) static water level (feet) 80 below top of ground.
- (4) casing Galvanize (material) (depth)
- (size) if telescope see back.
- (5) screen 8ft (length) (depth to top)
- 1 1/4 (size) (material)
- (6) pump 1/2 HP (type power) 3 1/2 (yield gpm)
- (7) electric log No (yes or no)
- No (organization running log)
- (8) how well bottom plugged Robert Seal


DRILLERS REMARKS:

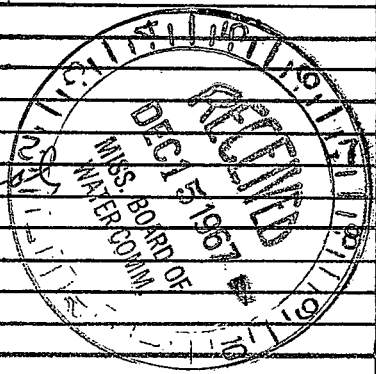

If well telescopes please sketch and show depths.

GROUND LEVEL

Well ←

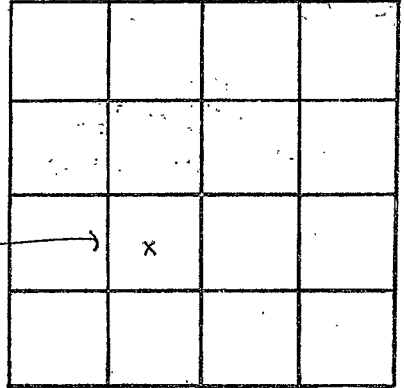

SECTION 26

Please indicate well location X.

ADDITIONAL INFORMATION

If more than one screen, show locations of each on sketch.