

TATE  
A 2010  
5-68

MISSISSIPPI  
BOARD OF WATER COMMISSIONERS  
416 North State Street  
Jackson, Mississippi 39201

WATER WELL DRILLERS LOG


May 17 1968 Shelby Newman Tate  
date well completed firm name county well located

LANDOWNER: <u>W.M. Kornegay</u>	description of formations encountered	from to
<u>R.F.D. - 1</u> <u>Coldwater Miss</u> (mailing address)	<u>Red Clay</u>	0 30
WELL LOCATION: sec. <u>28</u> T. <u>4</u> N. R. <u>9</u> E. S. W. <u>2 1/2</u> miles <u>W</u> of <u>Arboretum</u> (distance) (direction) (nearest town)	<u>Red sand &amp; gravel</u>	30 65
WELL PURPOSE: <u>Home</u> (home, irrigation, municipal, industrial)	<u>Blue clay</u>	65 90
WELL COMPLETION DATA:	<u>Blue sand &amp; clay</u>	90 110
(1) diameter (inches) <u>7</u>	<u>white clay</u>	110 160
(2) total depth (feet) <u>170</u>	<u>tan white sand</u>	160 175
(3) static water level (feet) <u>72</u> below top of ground.		
(4) casing <u>Galvanne 168</u> (material) (depth)		
_____ if telescope see back. (size)		
(5) screen <u>5</u> (length) (depth to top)		
<u>1 1/2</u> <u>Stainless Steel</u> (size) (material)		
(6) pump <u>1</u> <u>6</u> (HP) (yield gpm)		
<u>Electric</u> (type power)		
(7) electric log <u>No</u> (yes or no)		
<u>No</u> (organization running log)		
(8) how well bottom plugged <u>Rubber Seal</u>		
DRILLERS REMARKS:		

JUN 10 1968  
MISS. BOARD OF  
WATER COMMISSIONERS

If well telescopes please sketch and show depths.

GROUND LEVEL

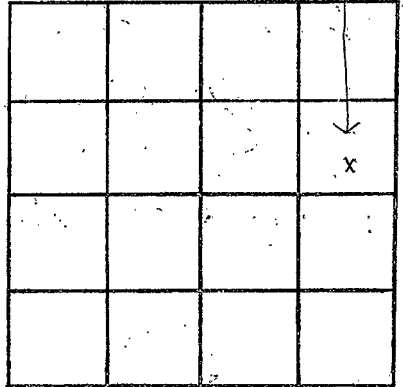

SECTION 28

Please indicate well location X.

ADDITIONAL INFORMATION

If more than one screen, show locations of each on sketch.