

TATE  
A 2011  
5-68

MISSISSIPPI  
BOARD OF WATER COMMISSIONERS  
416 North State Street  
Jackson, Mississippi 39201

WATER WELL DRILLERS LOG

Tate

May 24 1968 Shelby Keymer Tate  
date well completed firm name county well located

LANDOWNER: Joseph Moore  
Coldwater Miss RFD.  
(mailing address)

description of formations encountered	from	to
Red Clay	0	10
Red Sandy gravel	20	60
Blue Clay	60	126
White Sand	126	132

WELL LOCATION:  
sec. 25 T. 4 N R. 9 E  
S W  
1/2 miles N.E. of Osberton  
(distance) (direction) (nearest town)

WELL PURPOSE: Home  
(home, irrigation, municipal, industrial)

- WELL COMPLETION DATA:
- (1) diameter (inches) 2
  - (2) total depth (feet) 132
  - (3) static water level (feet) 80 below above top of ground.
  - (4) casing Galv. 12.6  
(material) (depth)
  - \_\_\_\_\_ if telescope see back.  
(size)
  - (5) screen 6 ft, \_\_\_\_\_  
(length) (depth to top)
  - 1/4" Gauge  
(size) (material)
  - (6) pump 1/4 HP, \_\_\_\_\_  
(HP) (yield gpm)
  - Electric  
(type power)
  - (7) electric log no  
(yes or no)
  - no  
(organization running log)
  - (8) how well bottom plugged Rubber Seal

JUN 10 1968  
MISS. BOARD OF  
WATER COMMISSIONERS

DRILLERS REMARKS:


If well telescopes please sketch and show depths.

GROUND LEVEL

WELL



X

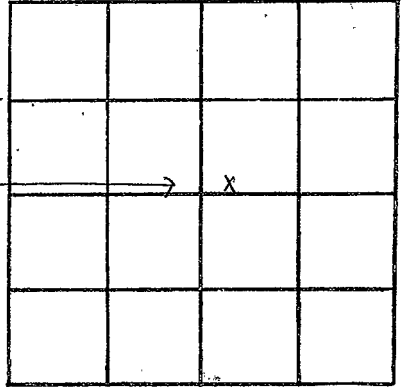

SECTION 25

Please indicate well location X.

ADDITIONAL INFORMATION

If more than one screen, show locations of each on sketch.