

TATE
 A 2012
 4-68

MISSISSIPPI
 BOARD OF WATER COMMISSIONERS
 416 North State Street
 Jackson, Mississippi 39201

WATER WELL DRILLERS LOG

April 4 1968 Shelly Neyman Tate
 date well completed firm name county well located


LANDOWNER:	Description of formations encountered	from	to
Theodor French P.O. 1 Coldwater Miss. (mailing address)	Red Clay	0	60
	Gravel & Sand	60	120
	Grey Clay	120	200
	Blue Sand	200	220
	White Sand	220	238

WELL LOCATION:
 sec. 30 T 4 N R 9 E
 S W W
 5 miles W of Arabhatta
 (distance) (direction) (nearest town)

WELL PURPOSE: Home
 (home, irrigation, municipal, industrial)

- WELL COMPLETION DATA:
- (1) diameter (inches) 2
 - (2) total depth (feet) 238
 - (3) static water level (feet) 101 below above top of ground.
 - (4) casing Galvane 131
 (material) (depth)
 if telescope see back.
 (size)
 - (5) screen 6 ft (length) (depth to top)
10 slot, Stainless Steel
 (size) (material)
 - (6) pump 1 (HP) 6 (yield gpm)
Electric
 (type power)
 - (7) electric log No
 (yes or no)

 (organization running log)
 - (8) how well bottom plugged Public Steel

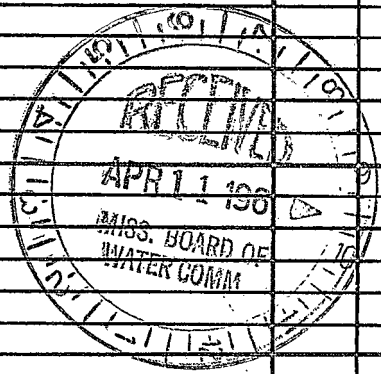


DRILLERS REMARKS:

If well telescopes please sketch and show depths.

GROUND LEVEL

Well

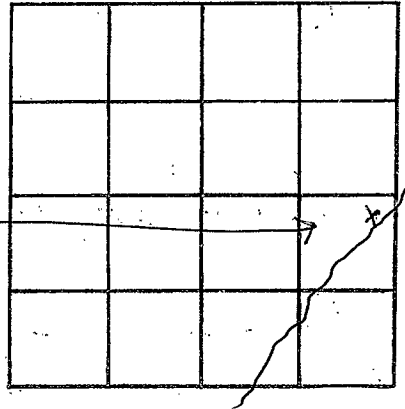

SECTION 30

Please indicate well location X.

ADDITIONAL INFORMATION

If more than one screen, show locations of each on sketch.