

**MISSISSIPPI
BOARD OF WATER COMMISSIONERS**
416 North State Street
Jackson, Mississippi 39201

WATER WELL DRILLERS LOG

Date
A 2013
8-68

and 8 19 68 *Shelly Neyman* *John*
date well completed firm name county well located

LANDOWNER:

Mary Tolbert
Coldwater Miss R.F. B.
(mailing address)

description of formations encountered

from to

<i>Red clay</i>	<i>0</i>	<i>10</i>
<i>B. gravel</i>	<i>10</i>	<i>60</i>
<i>Grey clay</i>	<i>60</i>	<i>120</i>
<i>Arhabatta solid Rock</i>	<i>120</i>	<i>171</i>
<i>Blue clay</i>	<i>121</i>	<i>160</i>
<i>Grey sand</i>	<i>160</i>	<i>280</i>

WELL LOCATION:

sec. 3 T. 4 N. R. 2 E. S. 9 W.
5 miles west of Arhabatta solid Rock
(distance) (direction) (nearest town)


WELL PURPOSE:

Home
(home, irrigation, municipal, industrial)

WELL COMPLETION DATA:


- (1) diameter (inches) 2
- (2) total depth (feet) 280
- (3) static water level (feet) 80 below top of ground.
- (4) casing Galvanize 2 1/2 (material) (depth)
9 (size) If telescope see back.
- (5) screen 5ft (length) (depth to top)
1/2 (size) Gauge (material)
- (6) pump 1/2 (HP) 4 (yield gpm)
Electric (type power)
- (7) electric log no (yes or no)
no (organization running log)
- (8) how well bottom plugged Hard

DRILLERS REMARKS:

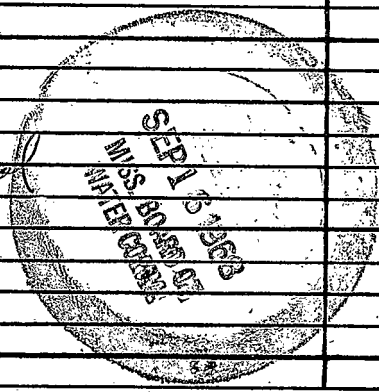

If well telescopes please sketch and show depths.

GROUND LEVEL

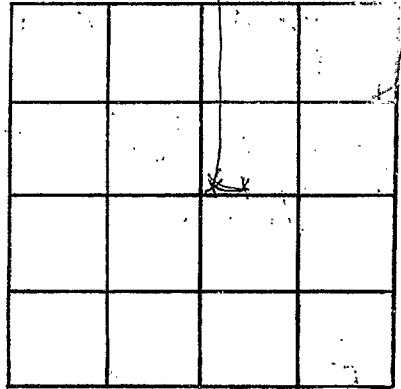

SECTION _____

Please indicate well location X.

ADDITIONAL INFORMATION

If more than one screen, show locations of each on sketch.