

Date  
A 2014  
7-20-76

MISSISSIPPI  
 BOARD OF WATER COMMISSIONERS  
 416 North State Street  
 15E Jackson, Mississippi 39201

WATER WELL DRILLERS LOG

7-20-76 19 Bob Smith Well Sv. Date  
 date well completed firm name county well located

LANDOWNER:  
Mary Tolbut  
Archieville, Ms.  
 (mailing address)

description of formations encountered	from	to
<u>top soil</u>	<u>0</u>	<u>5</u>
<u>red clay</u>	<u>5</u>	<u>40</u>
<u>red sand</u>	<u>40</u>	<u>100</u>
<u>blue shale</u>	<u>100</u>	<u>140</u>

WELL LOCATION:  
 sec. 9 T 4 N R. 9 E  
6 miles N of Archieville  
 (distance) (direction) (nearest town)

WELL PURPOSE:  
 (home, irrigation, municipal, industrial)


WELL COMPLETION DATA:  
 (1) diameter (inches) 4"  
 (2) total depth (feet) 140  
 (3) static water level (feet) 90 below/above top of ground.  
 (4) casing plastic 140  
 (material) (depth)  
 (size) If telescope see back.  
 (5) screen 10 130  
 (length) (depth to top)  
4 plastic  
 (size) (material)  
 (6) pump 1/3 5  
 (HP) (yield gpm)  
Elec  
 (type power)  
 (7) electric log (yes or no)  
 (organization running log)  
 (8) how well bottom plugged

DRILLERS REMARKS:

**RECEIVED**  
 SEP 20 1976  
 MISS. BD. OF WATER COMMISSIONERS

If well telescopes please sketch and show depths.

GROUND LEVEL

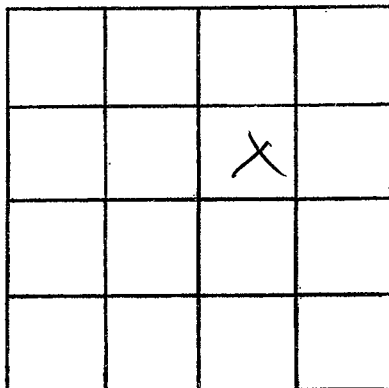

SECTION \_\_\_\_\_

Please indicate well location X.

ADDITIONAL INFORMATION

If more than one screen, show locations of each on sketch.