

Tate  
 A 2015  
 6-18-76

MISSISSIPPI  
 BOARD OF WATER COMMISSIONERS  
 416 North State Street  
 15E Jackson, Mississippi 39201

WATER WELL DRILLERS LOG

6-18-76 19 Sub Surface Well Serv. Tate  
 date well completed firm name county well located

LANDOWNER:  
Roy Williams  
Coldwater, Miss.  
 (mailing address)

description of formations encountered	from	to
<u>top soil</u>	<u>0</u>	<u>5</u>
<u>red clay</u>	<u>5</u>	<u>40</u>
<u>red sand</u>	<u>40</u>	<u>85</u>
<u>blue clay</u>	<u>85</u>	<u>200</u>
<u>sand</u>	<u>200</u>	<u>250</u>

WELL LOCATION:  
 sec. 10 T. 4 N. R. 9 E.  
6 miles N of Arbitator  
 (distance) (direction) (nearest town)

WELL PURPOSE:  
 (home, irrigation, municipal, industrial)


WELL COMPLETION DATA:  
 (1) diameter (inches) 4"  
 (2) total depth (feet) 250'  
 (3) static water level (feet) 97' below above top of ground.  
 (4) casing plastic 250'  
 (material) (depth)  
 (size) If telescope see back.  
 (5) screen 20' 240'  
 (length) (depth to top)  
4" plastic  
 (size) (material)  
 (6) pump 1/2 10  
 (HP) (yield gpm)  
Elec.  
 (type power)  
 (7) electric log (yes or no) (no)  
 (organization running log)  
 (8) how well bottom (plugged)

DRILLERS REMARKS:

RECEIVED  
 SEP 20 1976  
 MISS. Bd. OF WATER COMMISSIONERS

If well telescopes please sketch and show depths.

GROUND LEVEL

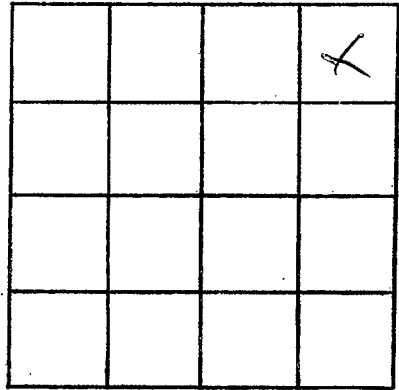

SECTION \_\_\_\_\_

Please indicate well location X.

ADDITIONAL INFORMATION

If more than one screen,  
show locations of each on sketch.