

TATE
 R 2016
 1-15-76

MISSISSIPPI
 BOARD OF WATER COMMISSIONERS
 416 North State Street
 Jackson, Mississippi 39201

WATER WELL DRILLERS LOG

1-15-76
 date well completed

HICKS Well 00
 firm name

TATE
 county well located

LANDOWNER: William Korney

description of formations encountered

from to

Arkabutla Miss

Red Clay

0 30

Shale

30 80

(mailing address)

Clay & Sand

50 130

White Sand

130 167

WELL LOCATION:

sec 28 T 4 N R 9 E
 S W

2 miles NE of Arkabutla
 (distance) (direction) (nearest town)

WELL PURPOSE: Home
 (home, irrigation, municipal, industrial)

WELL COMPLETION DATA:

- (1) diameter (inches) 4"
- (2) total depth (feet) 167
- (3) static water level (feet) 60 below above top of ground.

(4) casing PVC 167
 (material) (depth)

(size) if telescope see back.

(5) screen PVC 7'
 (length) (depth to top)

4" inside Shaul
 (size) (material)

(6) pump 1/2 10
 (HP) (yield gpm)


220 Elm
 (type power)

(7) electric log NO
 (yes or no)

(organization running log)

(8) how well bottom plugged Cap


DRILLERS REMARKS:

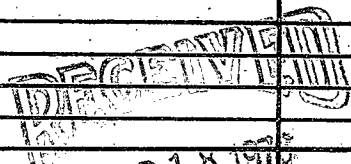

MISS. BD. OF WATER COMMISSIONERS

If well telescopes please sketch and show depths.

GROUND LEVEL

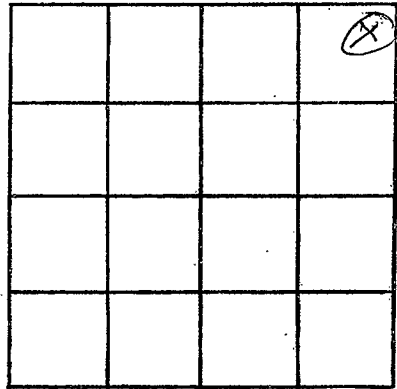

SECTION 28

Please indicate well location X.

ADDITIONAL INFORMATION

If more than one screen, show locations of each on sketch.