

TATE
A 207
1-19-76

MISSISSIPPI
BOARD OF WATER COMMISSIONERS
416 North State Street
15E Jackson, Mississippi 39201

WATER WELL DRILLERS LOG

1-19 1976 Hicks well CO TATE
date well completed firm name county well located

LANDOWNER: Howard Hubbard	description of formations encountered	from	to
(mailing address)			
Ark2but12 Miss	Red Clay	0	25
	Clay & Shale	0	110
	Red Clay	110	180
	White Sand	180	210

WELL LOCATION:
sec 25 T 4 N R 10 E
6 miles NE of Ark2but12
(distance) (direction) (nearest town)

WELL PURPOSE: Home
(home, irrigation, municipal, industrial)


- WELL COMPLETION DATA:
- (1) diameter (inches) 1"
 - (2) total depth (feet) 210
 - (3) static water level (feet) 90 below top of ground.
 - (4) casing PVC, 210 (material), (depth)
(size) If telescope see back.
 - (5) screen 7' (length), 7' (depth to top)
4" (size), PVC (material)
 - (6) pump 3/4 (HP), 10 (yield gpm)
220 elc (type power)
 - (7) electric log NO (yes or no)
(organization running log)
 - (8) how well bottom plugged Cap

DRILLERS REMARKS:

RECEIVED
FEB 18 1976

If well telescopes please sketch and show depths.

GROUND LEVEL

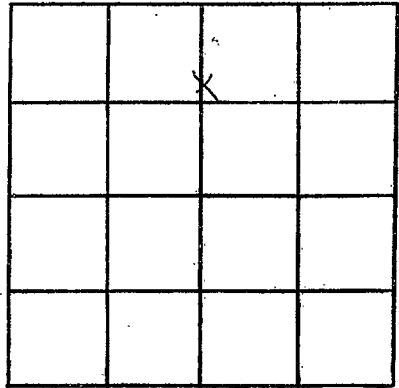

SECTION 25

Please indicate well location X.

ADDITIONAL INFORMATION

If more than one screen,
show locations of each on sketch.