

Tate
A 2018
5-24-76

MISSISSIPPI
 BOARD OF WATER COMMISSIONERS
 416 North State Street
 15E Jackson, Mississippi 39201

WATER WELL DRILLERS LOG

5-24-76 date well completed 1976 Sub Smith Well Sr. firm name Tate county well located

LANDOWNER:
Ella Dean Church
Arkabutla, Ms.
 (mailing address)

description of formations encountered	from	to
	<u>top soil</u>	<u>0</u>
<u>red clay</u>	<u>5</u>	<u>40</u>
<u>sand + gravel</u>	<u>40</u>	<u>95</u>
<u>fine white sand</u>	<u>95</u>	<u>120</u>

WELL LOCATION:
 sec. 11 T. 4 N. R. 9 E.
5 miles (distance) N (direction) of Arkabutla (nearest town)

WELL PURPOSE:
Church
 (home, irrigation, municipal, industrial)


- WELL COMPLETION DATA:
- (1) diameter (inches) 4"
 - (2) total depth (feet) 120'
 - (3) static water level (feet) 60' below top of ground.
 - (4) casing plastic, 120' (material) (depth)
 - _____ If telescope see back. (size)
 - (5) screen 10', 110' (length) (depth to top)
 - 4" (size) plastic (material)
 - (6) pump 1/3 (HP) 5 (yield gpm)
 - Elec. (type power)
 - (7) electric log (yes or no) no
 - _____ (organization running log)
 - (8) how well bottom plugged plugged

DRILLERS REMARKS:

RECEIVED
 SEP 20 1976

If well telescopes please sketch and show depths.

GROUND LEVEL

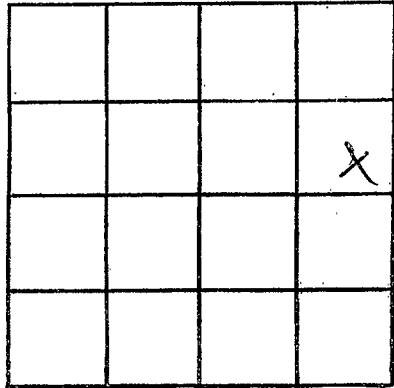

SECTION _____

Please indicate well location X.

ADDITIONAL INFORMATION

If more than one screen, show locations of each on sketch.