

Tate
 A 2210
 7-19-76

MISSISSIPPI
 BOARD OF WATER COMMISSIONERS
 416 North State Street
 15E Jackson, Mississippi 39201

WATER WELL DRILLERS LOG

7-19-76 19 date well completed
 Bob Lincewell Sr. firm name
 Tate county well located

LANDOWNER:
 Robert L Tate
 Ashburn, Ms.
 (mailing address)

description of formations encountered	from	to
	top soil	0
red clay	5	40
gravel	40	90
white sand	90	150

WELL LOCATION:
 sec. 15 T 4 N R 9 E
 4 miles N of Ashburn
 (distance) (direction) (nearest town)

WELL PURPOSE:
 (home, irrigation, municipal, industrial)


WELL COMPLETION DATA:
 (1) diameter (inches) 4"
 (2) total depth (feet) 150
 (3) static water level (feet) 80 below top of ground.
 (4) casing plastic 150 (material) (depth)
 (size) if telescope see back.
 (5) screen 10 140 (length) (depth to top)
 4 plastic (size) (material)
 (6) pump 1/3 5 (HP) (yield gpm)
 E. Lee (type power)
 (7) electric log (yes or no) no
 (organization running log)
 (8) how well bottom plugged

DRILLERS REMARKS:

RECEIVED
 SEP 20 1976
 MISS. BD. OF WATER COMMISSIONERS

If well telescopes please sketch and show depths.

GROUND LEVEL

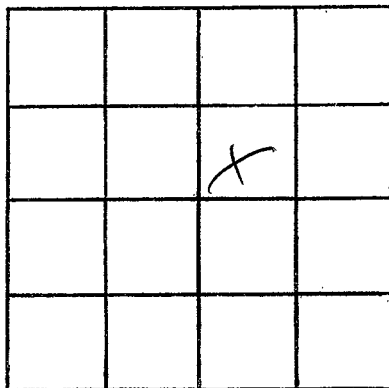

SECTION _____

Please indicate well location X.

ADDITIONAL INFORMATION

If more than one screen, show locations of each on sketch.