

Tate  
 A 2000  
 10-21-76

MISSISSIPPI  
 BOARD OF WATER COMMISSIONERS  
 416 North State Street  
 Jackson, Mississippi 39201

WATER WELL DRILLERS LOG

10-21-1976 date well completed  
 Bill Well Co firm name  
 Tate county well located


LANDOWNER: <u>Helen Bigham</u>	description of formations encountered	from	to
<u>Coldwater, Ms.</u> (mailing address)	<u>Red Clay</u>	<u>0</u>	<u>45</u>
	<u>Red Sand + Gravel</u>	<u>45</u>	<u>90</u>
	<u>Black Clay + Gravel</u>	<u>90</u>	<u>125</u>
	<u>White Sand</u>	<u>125</u>	<u>160</u>
WELL LOCATION: sec <u>27</u> T <u>4</u> N R <u>9</u> E <u>2</u> miles (distance) <u>ENE</u> (direction) of <u>Osaka, Mo</u> (nearest town)			
WELL PURPOSE: <u>Home</u> (home, irrigation, municipal, industrial)			
WELL COMPLETION DATA:			
(1) diameter (inches) <u>4</u>			
(2) total depth (feet) <u>160</u>			
(3) static water level (feet) <u>60</u> below above top of ground.			
(4) casing <u>PVC</u> <u>160</u> (material) (depth)			
_____ If telescope see back. (size)			
(5) screen <u>7'</u> <u>153'</u> (length) (depth to top)			
(6) pump <u>4"</u> <u>Gravel Type</u> (size) (material)			
(6) pump <u>1/2</u> <u>10</u> (HP) (yield gpm)			
(7) electric log <u>no</u> (yes or no)			
_____ (organization running log)			
(8) how well bottom plugged <u>Cap</u>			
DRILLERS REMARKS:			

RECEIVED  
 JAN 4 1977

MISS. RD. OF WATER COMMISSIONERS

If well telescopes please sketch and show depths.

GROUND LEVEL

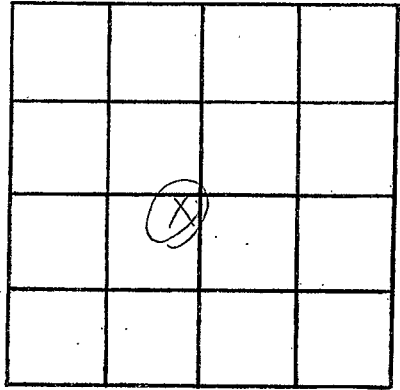

SECTION 27

Please indicate well location X.

ADDITIONAL INFORMATION

If more than one screen,  
show locations of each on sketch.