

Date
 A 2022
 7-12-77

MISSISSIPPI
 BOARD OF WATER COMMISSIONERS
 416 North State Street
 Jackson, Mississippi 39201

156

WATER WELL DRILLERS LOG

7-12-77 19 date well completed
 Hicks well co firm name
 TATE county well located

LANDOWNER: Sidney Furniss
RT-1 Box 157
Caldwell Miss
 (mailing address)

description of formations encountered	from	to
Red Clay	0	45
Red sand	45	55
Gravel	55	90
White sand	90	103

WELL LOCATION:
 sec. 28 T 4 N R 9 E
2 1/2 miles N-W of ARKHUR
 (distance) (direction) (nearest town)

WELL PURPOSE: Dom P
 (home, irrigation, municipal, industrial)

- WELL COMPLETION DATA:
- (1) diameter (inches) 4"
 - (2) total depth (feet) 103
 - (3) static water level (feet) 65 below above top of ground.
 - (4) casing PVC, 9.5,
 (material) (depth)
 (size) If telescope see back.
 - (5) screen 7', 7'
 (length) (depth to top)
4", initial PVC
 (size) (material)
 - (6) pump 1/2 (HP) 10 (yield gpm)
Cha
 (type power)
 - (7) electric log _____
 (yes or no)


 (organization running log)
 - (8) how well bottom plugged Cap

DRILLERS REMARKS:

RECEIVED
 AUG 19 1977
 MISS. BD. OF WATER COMMISSIONERS

If well telescopes please sketch and show depths.

GROUND LEVEL

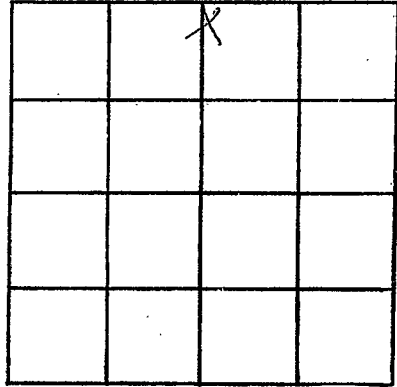

SECTION _____

Please indicate well location X.

ADDITIONAL INFORMATION

A series of horizontal lines for recording additional information, starting below the 'ADDITIONAL INFORMATION' header and extending to the bottom of the page.

If more than one screen, show locations of each on sketch.