

TATE
 A 2023
 10/11/77

MISSISSIPPI
 BOARD OF WATER COMMISSIONERS
 416 North State Street
 15E Jackson, Mississippi 39201

WATER WELL DRILLERS LOG

10-11 1977 High Well Co. Tate
 date well completed firm name county well located

LANDOWNER: <u>Anna H. Sandberry</u> <u>Rt. 2</u>	description of formations encountered	from	to
<u>Senatobia, Ms.</u> (mailing address)	<u>Red clay</u>	<u>0</u>	<u>30</u>
WELL LOCATION: sec. <u>31</u> T. <u>4</u> N. R. <u>9</u> E. <u>6</u> miles <u>W</u> of <u>Coldwater</u> (distance) (direction) (nearest town)	<u>Black clay</u>	<u>30</u>	<u>120</u>
WELL PURPOSE: <u>Home</u> (home, irrigation, municipal, industrial)	<u>white sand + clay</u>	<u>120</u>	<u>140</u>
WELL COMPLETION DATA: (1) diameter (inches) <u>4"</u>	<u>Black Clay</u>	<u>140</u>	<u>150</u>
(2) total depth (feet) <u>150</u>			
(3) static water level (feet) <u>90</u> below top of ground.			
(4) casing <u>PVC</u> , <u>150</u> (material) (depth)			
(5) screen <u>134</u> , <u>115</u> (size) (length) (depth to top)			
<u>4"</u> , <u>gravel type</u> (size) (material)			
(6) pump <u>72</u> <u>10</u> (HP) (yield gpm)			
(7) electric log <u>220 V</u> (type power)			
(7) electric log <u>no</u> (yes or no)			
(8) how well bottom plugged <u>Cap</u>			
DRILLERS REMARKS:			


RECEIVED

NOV - 7 1977

MISS. Bd. OF WATER COMMISSIONERS

If well telescopes please sketch and show depths.

GROUND LEVEL

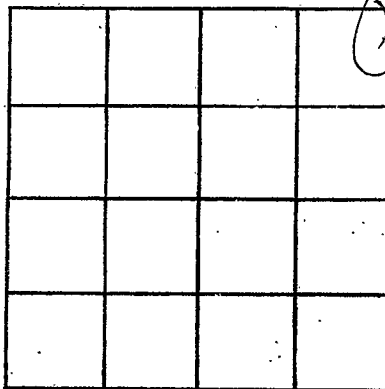

SECTION 31

Please indicate well location X.

ADDITIONAL INFORMATION

Lined area for additional information.

If more than one screen, show locations of each on sketch.