

TATE
A
2003

**MISSISSIPPI  
BOARD OF WATER COMMISSIONERS**  
416 North State Street  
Jackson, Mississippi 39201

**WATER WELL DRILLERS LOG**

9-5-77 19 Bob Smith Well Serv. Date \_\_\_\_\_  
 date well completed firm name county well located

**LANDOWNER:**  
W.L. Bendren  
Archieville, Ms.  
 (mailing address)

**WELL LOCATION:**  
 sec 23 T 4 N R 9 E  
3 miles W of Archieville  
 (distance) (direction) (nearest town)

**WELL PURPOSE:**  
 (home, irrigation, municipal, industrial)

- WELL COMPLETION DATA:**
- (1) diameter (inches) 4"
  - (2) total depth (feet) 130
  - (3) static water level (feet) 90 below top of ground.
  - (4) casing Plastic, 130  
 (material) (depth)  
 (size) if telescope see back.
  - (5) screen 20, 110  
 (length) (depth to top)  
4", Plastic  
 (size) (material)
  - (6) pump 1/3, 5  
 (HP) (yield gpm)  
Elec  
 (type power)
  - (7) electric log (yes or no) (no)  
 (organization running log)
  - (8) how well bottom plugged

description of formations encountered	from	to
<u>top soil</u>	<u>0</u>	<u>5</u>
<u>red clay</u>	<u>5</u>	<u>30</u>
<u>gravel</u>	<u>30</u>	<u>50</u>
<u>white sand</u>	<u>50</u>	<u>130</u>

**RECEIVED**


MAY 30 1978

MISS. BD. OF WATER COMMISSIONERS

**DRILLERS REMARKS:**

If well telescopes please  
sketch and show depths.

GROUND LEVEL

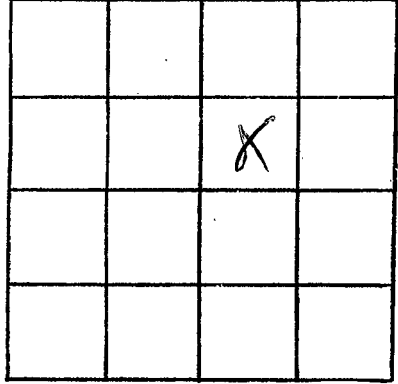

SECTION \_\_\_\_\_

Please indicate well location X.

ADDITIONAL INFORMATION

If more than one screen,  
show locations of each on sketch.