

TATE  
 A 2025  
 10/21/77

MISSISSIPPI  
 BOARD OF WATER COMMISSIONERS  
 416 North State Street  
 Jackson, Mississippi 39201

WATER WELL DRILLERS LOG

10-21 1977 <sup>15E</sup> Kick Well Co. Tate  
 date well completed firm name county well located

LANDOWNER: John Like  
 Rt. 2  
 Caldwell, Ms.  
 (mailing address)

description of formations encountered	from	to
	Clay	0
Gravel	15	20

WELL LOCATION:  
 sec. 9 T. 4 N. R. 9 E  
 5 miles NW of Akshobla  
 (distance) (direction) (nearest town)

white sand	20	65
------------	----	----

WELL PURPOSE: Home  
 (home, irrigation, municipal, industrial)

WELL COMPLETION DATA:

(1) diameter (inches) 4

(2) total depth (feet) 65

(3) static water level (feet) 40 below above top of ground.

(4) casing PVC 65 (material) (depth)  
 (size) If telescope see back.

(5) screen 7ft 58 (length) (depth to top)  
 4" gravel type (size) (material) 1/2

(6) pump 1/2 10 (HP) (yield gpm)  
 220V (type power)

(7) electric log No (yes or no)

(organization running log)

(8) how well bottom plugged Cap


DRILLERS REMARKS:

RECEIVED  
 NOV - 7 1977

MISS. Bd. OF WATER COMM.

If well telescopes please sketch and show depths.

GROUND LEVEL

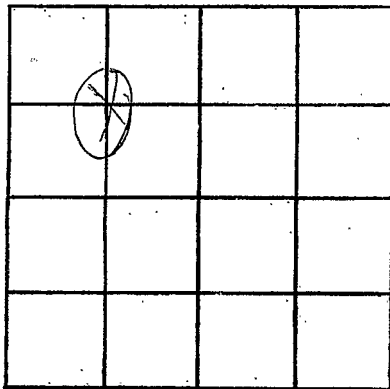

SECTION 9

Please indicate well location X.

ADDITIONAL INFORMATION

If more than one screen, show locations of each on sketch.