

TATE
A 2003

MISSISSIPPI
BOARD OF WATER COMMISSIONERS
416 North State Street
Jackson, Mississippi 39201

WATER WELL DRILLERS LOG

7-12 1978 date well completed Hicks Well Co firm name Tate county well located

LANDOWNER: <u>Alton Moorehead</u>	description of formations encountered	from	to
<u>Ret. 1, Box 17A</u> <u>Caldwater, Ms.</u> (mailing address)			
<p>WELL LOCATION: sec. <u>33</u> T. <u>4</u> N. R. <u>9</u> E. <u>3 1/2</u> miles <u>N</u> of <u>Hicksville</u> (distance) (direction) (nearest town)</p>	<u>Red clay</u>	<u>0</u>	<u>40</u>
	<u>Red clay + sand</u>	<u>40</u>	<u>60</u>
	<u>sand</u>	<u>60</u>	<u>90</u>
<p>WELL PURPOSE: <u>Home</u> (home, irrigation, municipal, industrial)</p>			
<p>WELL COMPLETION DATA:</p> <p>(1) diameter (inches) <u>4</u></p> <p>(2) total depth (feet) <u>90</u></p> <p>(3) static water level (feet) <u>50</u> below top of ground.</p> <p>(4) casing <u>PVC</u>, <u>90</u> (material) (depth)</p> <p>_____ if telescope see back. (size)</p> <p>(5) screen <u>10</u>, <u>80</u> (length) (depth to top)</p> <p><u>4"</u>, <u>PVC-SLOTTED</u> (size) (material)</p> <p>(6) pump <u>1/2</u>, <u>10</u> (HP) (yield gpm)</p> <p><u>220V</u> (type power)</p> <p>(7) electric log <u>No</u> (yes or no)</p> <p>_____ (organization running log)</p> <p>(8) how well bottom plugged <u>Cap</u></p>			
<p>DRILLERS REMARKS:</p>			


RECEIVED

JUL 21 1978

MISS. BD. OF WATER COMMISSIONERS

If well telescopes please sketch and show depths.

GROUND LEVEL

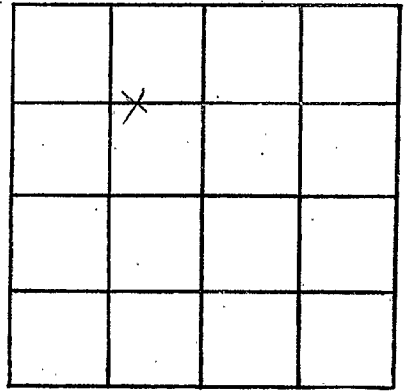

SECTION 33

Please indicate well location X.

ADDITIONAL INFORMATION

If more than one screen, show locations of each on sketch.