

Tate
A 2017
12-12-79

MISSISSIPPI
BOARD OF WATER COMMISSIONERS
416 North State Street
Jackson, Mississippi 39201

WATER WELL DRILLERS LOG

12-12 19 79 Wells Well Co. Tate
date well completed firm name county well located

LANDOWNER:
Perry Mangrum
Rt. 1, Clodwater
(mailing address)

description of formations encountered	from	to
<u>clay</u>	<u>0</u>	<u>30</u>
<u>gravel</u>	<u>60</u>	<u>110</u>
<u>sand</u>	<u>50</u>	<u>155</u>

WELL LOCATION:
sec. 10 T. 4 N R. 9 E
1/2 miles West of Carhendale
(distance) (direction) (nearest town)

WELL PURPOSE: home
(home, irrigation, municipal, industrial)

- WELL COMPLETION DATA:
- (1) diameter (inches) 4 in
 - (2) total depth (feet) 155
 - (3) static water level (feet) 110 below top of ground
 - (4) casing Plastic 155
(material) (depth)
 - (size) if telescope see back.
 - (5) screen 7 ft 148
(length) (depth to top)
4 in Gravel
(size) (material)
 - (6) pump 1/2 10
(HP) (yield gpm)
220
(type power)
 - (7) electric log No
(yes or no)

(organization running log)
(8) how well bottom plugged Cap

DRILLERS REMARKS:


DEPT. OF NATURAL RESOURCES
BUREAU OF LAND & WATER RESOURCES

JAN 9 1980

RECEIVED

If well telescopes please sketch and show depths.

GROUND LEVEL

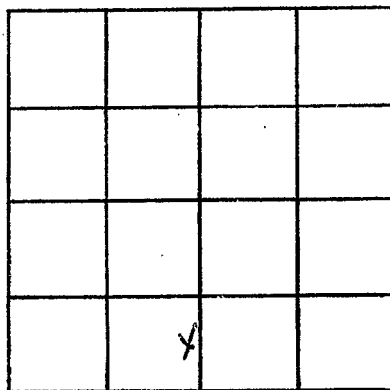

SECTION 10

Please indicate well location X.

ADDITIONAL INFORMATION

If more than one screen,
show locations of each on sketch.