

TATE
A 2039
04-18-79

**MISSISSIPPI  
BOARD OF WATER COMMISSIONERS**  
416 North State Street  
Jackson, Mississippi 39201

**WATER WELL DRILLERS LOG**

4-18 19 79 Wicks Well Co. Tate  
 date well completed firm name county well located

**LANDOWNER:**  
Charles M. Johnson  
Arbuckle Miss.  
 (mailing address)

description of formations encountered	from	to
<u>Red Clay</u>	<u>0</u>	<u>15</u>
<u>Clay &amp; Gravel</u>	<u>15</u>	<u>70</u>
<u>Clay &amp; Sand</u>	<u>70</u>	<u>120</u>
<u>White Sand</u>	<u>120</u>	<u>165</u>

**WELL LOCATION:**  
 sec. 16 T 4 N R 9 E  
2 miles SW of Arbuckle  
 (distance) (direction) (nearest town)

**WELL PURPOSE:** Home  
 (home, irrigation, municipal, industrial)

**WELL COMPLETION DATA:**

(1) diameter (inches) 4 in.

(2) total depth (feet) 165

(3) static water level (feet) 120 below above top of ground.

(4) casing Plastic 165 ft  
 (material) (depth)

(size) if telescope see back.

(5) screen 7 ft 158 ft  
 (length) (depth to top)

4 in. Gravel  
 (size) (material)

(6) pump 1/2 10  
 (HP) (yield gpm)

220  
 (type power)

(7) electric log No  
 (yes or no)

(organization running log)

(8) how well bottom plugged Cap

**DRILLERS REMARKS:**


Miss. Board of Water Comm.

APR 26 1979

**RECEIVED**

If well telescopes please sketch and show depths.

GROUND LEVEL

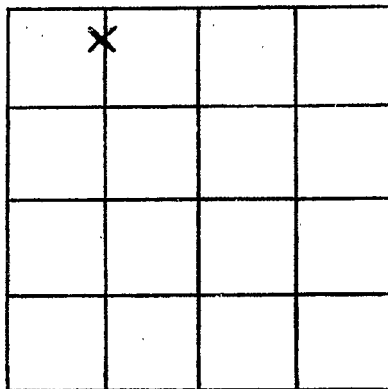

SECTION 16

Please indicate well location X.

ADDITIONAL INFORMATION

If more than one screen, show locations of each on sketch.