

Tate
 A 2030
 5-29-79

MISSISSIPPI
 BOARD OF WATER COMMISSIONERS
 416 North State Street
 Jackson, Mississippi 39201

WATER WELL DRILLERS LOG

5-29-79 19 date well completed
 J.B. Cain firm name
 Tate county well located

LANDOWNER: Arkabutla Church Christi
Arkabutla Miss
 (mailing address)

description of formations encountered	from to	
Clay	0	22
Shand	22	60
Clay	60	170
Sand	170	200

WELL LOCATION:
 sec. 20 T. 4 N. R. 9 E
4 miles W of Arkabutla
 (distance) (direction) (nearest town)

WELL PURPOSE: Church
 (home, irrigation, municipal, industrial)

- WELL COMPLETION DATA:
- (1) diameter (inches) 4
 - (2) total depth (feet) 200
 - (3) static water level (feet) 80 below above
top of ground.
 - (4) casing Phoslin, 200
(material) (depth)
(size) If telescope see back.
 - (5) screen 10" 190
(length) (depth to top)
4", Phoslin
(size) (material)
 - (6) pump 3/4 12
(HP) (yield gpm)
Elect
(type power)
 - (7) electric log _____
(yes or no)
(organization running log)
 - (8) how well bottom plugged check Bottom

Miss. Board of Water Comm.


JUN 14 1979

DRILLERS REMARKS:

RECEIVED

If well telescopes please sketch and show depths.

GROUND LEVEL

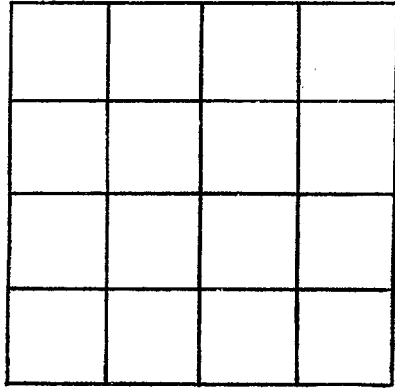

SECTION _____

Please indicate well location X.

ADDITIONAL INFORMATION

Lined area for providing additional information, consisting of 20 horizontal lines.

If more than one screen, show locations of each on sketch.