

Tate
A2034
9-28-79

MISSISSIPPI
BOARD OF WATER COMMISSIONERS
416 North State Street
Jackson, Mississippi 39201

WATER WELL DRILLERS LOG

9-28 date well completed 19 79 firm name Wicks Well Co county well located Tate

LANDOWNER:
Sam Hopkins
(mailing address)
WELL LOCATION:
sec. 16 T 4 N R 9 E
2 miles S of Arkalinda
(distance) (direction) (nearest town)

description of formations encountered	from	to
<u>Red Clay</u>	<u>0</u>	<u>30</u>
<u>Black Clay</u>	<u>30</u>	<u>170</u>
<u>White sand</u>	<u>170</u>	<u>230</u>

WELL PURPOSE: home
(home, irrigation, municipal, industrial)

WELL COMPLETION DATA:
(1) diameter (inches) 4 in
(2) total depth (feet) 230
(3) static water level (feet) _____ below above top of ground.
(4) casing Plastic 230
(material) (depth)
(size) If telescope see back.
(5) screen 1/4" 223
(length) (depth to top)
4 in Gravel
(size) (material)
(6) pump 1/2 10
(HP) (yield gpm)
220
(type power)
(7) electric log No
(yes or no)
(organization running log)
(8) how well bottom plugged Cap


DRILLERS REMARKS:

DEPT. OF NATURAL RESOURCES
BUREAU OF LAND & WATER RESOURCES

OCT 29 1979
RECEIVED

If well telescopes please sketch and show depths.

GROUND LEVEL

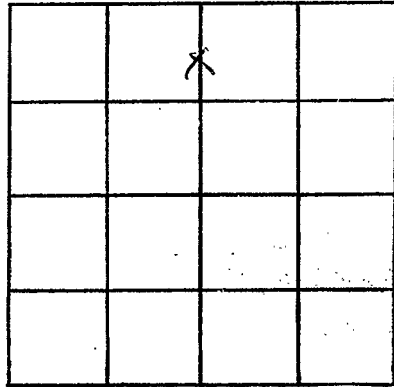

SECTION 16

Please indicate well location X.

ADDITIONAL INFORMATION

If more than one screen, show locations of each on sketch.