

Tate
A 2032
10-9-79

MISSISSIPPI
BOARD OF WATER COMMISSIONERS
416 North State Street
Jackson, Mississippi 39201

WATER WELL DRILLERS LOG

10-9 date well completed 19 79 firm name Rich Well Co. Tate county well located

LANDOWNER:
Theonius Frank
(mailing address)

description of formations encountered	from	to
Red Clay	0	30
Black Clay	30	160
white sand	160	220

WELL LOCATION:
sec. 24 T. 4 N. R. 10 E
5 miles W of Columbus
(distance) (direction) (nearest town)

WELL PURPOSE: home
(home, irrigation, municipal, industrial)

WELL COMPLETION DATA:

(1) diameter (inches) 4 in

(2) total depth (feet) 220

(3) static water level (feet) _____ below above top of ground.

(4) casing Plastic, 220, (material) (depth)

(size) If telescope see back.

(5) screen 7 ft, 213 (length) (depth to top)
4 in, gravel (size) (material)

(6) pump 3/4, 14 (HP) (yield gpm)
220 (type power)

(7) electric log No (yes or no)

(organization running log)

(8) how well bottom plugged Cap

DRILLERS REMARKS:


DEPT. OF NATURAL RESOURCES
BUREAU OF LAND & WATER RESOURCES

OCT 25 1979

RECEIVED

If well telescopes please sketch and show depths.

GROUND LEVEL

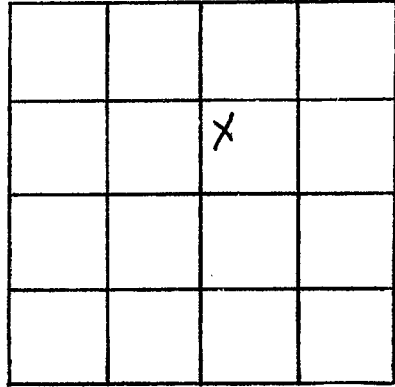

SECTION 24

Please indicate well location X.

ADDITIONAL INFORMATION

If more than one screen, show locations of each on sketch.