

WTO-MH

Tate  
A 2038  
12-19-79  
12-19

MISSISSIPPI  
BOARD OF WATER COMMISSIONERS  
416 North State Street  
Jackson, Mississippi 39201

WATER WELL DRILLERS LOG

19 79 Rich Well Co

Tate

date well completed

firm name

county well located

LANDOWNER:  
Willie Darnes  
Rt 1, Coldwater Miss.  
(mailing address)

description of formations encountered	from	to
Clay	0	50
red sand	60	110
<del>110-189</del>		
white sand	110	189

WELL LOCATION:  
sec. 11 T. 45 N. R. 809 E  
3 miles West of Archedale  
(distance) (direction) (nearest town)

WELL PURPOSE: home  
(home, irrigation, municipal, industrial)

WELL COMPLETION DATA:

(1) diameter (inches) 4 in

(2) total depth (feet) 189

(3) static water level (feet) 120 below top of ground.

(4) casing Plastic 189  
(material) (depth)

(size) If telescope see back.

(5) screen 115 182  
(length) (depth to top)

4 in Brunel  
(size) (material)

(6) pump 1/2 10  
(HP) (yield gpm)

1/2 200  
(type power)

(7) electric log No  
(yes or no)

(organization running log)

(8) how well bottom plugged Cop

DRILLERS REMARKS:


DEPT. OF NATURAL RESOURCES  
BUREAU OF LAND & WATER RESOURCES

JAN 9 1980

RECEIVED

If well telescopes please sketch and show depths.

GROUND LEVEL

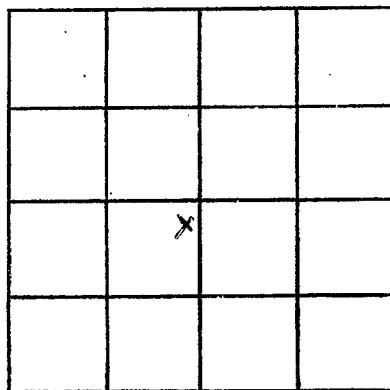

SECTION 11

Please indicate well location X.

ADDITIONAL INFORMATION

If more than one screen, show locations of each on sketch.