

Tate
A 2035
7-31-80

MISSISSIPPI
BOARD OF WATER COMMISSIONERS
416 North State Street
Jackson, Mississippi 39201

WATER WELL DRILLERS LOG

7-31-1980 Hiche Well Co. Tate
date well completed firm name county well located

LANDOWNER: Charles Hammond
Hickabuttle Corn
Caldwate, MS.
(mailing address)

description of formations encountered	from	to
clay	0	30
sand	30	80
Clay	80	125

WELL LOCATION:
sec. 21 T 4 N R 9 E
3 miles NW of Hickabuttle
(distance) (direction) (nearest town)

WELL PURPOSE: Home
(home, irrigation, municipal, industrial)

- WELL COMPLETION DATA:
- (1) diameter (inches) 4"
 - (2) total depth (feet) 125
 - (3) static water level (feet) 50 below top of ground.
 - (4) casing PVC, 125' (material) (depth)
If telescope see back.
(size)
 - (5) screen 7' 73' (length) (depth to top)
4" gravel type (size) (material)
 - (6) pump 1/2 HP, 10 (yield gpm)
220V (type power)
 - (7) electric log No (yes or no)
(organization running log)
 - (8) how well bottom plugged Cap

Screen set at 90 ft

DRILLERS REMARKS:


DEPT. OF NATURAL RESOURCES
BUREAU OF LAND & WATER RESOURCES

SEP 26 1980

RECEIVED

If well telescopes please sketch and show depths.

GROUND LEVEL

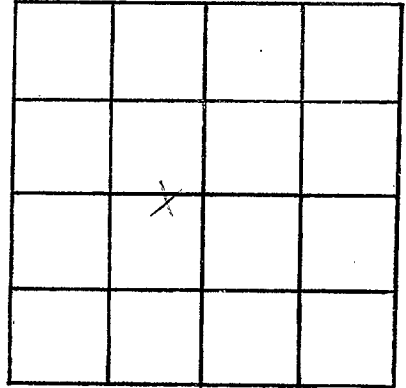

SECTION 21

Please indicate well location X.

ADDITIONAL INFORMATION

If more than one screen,
show locations of each on sketch.