

TATE
A 2036
5/6/80

MISSISSIPPI
BOARD OF WATER COMMISSIONERS
416 North State Street
Jackson, Mississippi 39201

WATER WELL DRILLERS LOG

5/6/80
date well completed

19 Bob Smith & Co
firm name

Tate
county well located

LANDOWNER:

Michael Ulbrich
Coldwater, Miss.
(mailing address)

description of formations
encountered

from to

top soil	0	5
red clay	5	40
sand & gravel	40	95

WELL LOCATION:

sec. 28 T 4 N R 9 E
(S) (W)
3/4 miles W of Coldwater
(distance) (direction) (nearest town)

WELL PURPOSE:

(home) irrigation, municipal, industrial

WELL COMPLETION DATA:

- (1) diameter (inches) 4"
- (2) total depth (feet) 95'
- (3) static water level (feet) 88' below top of ground.
- (4) casing plastic 95' (material) (depth)
- (size) if telescope see back.
- (5) screen 15' 95' (length) (depth to top)
- 4" plaster (size) (material)
- (6) pump 1/2 7 (HP) (yield gpm)
- elec (type power)
- (7) electric log (yes or no)

(organization running log)

(8) how well bottom plugged cap

DRILLERS REMARKS:


DEPT. OF NATURAL RESOURCES
BUREAU OF LAND & WATER RESOURCES

OCT 15 1980

RECEIVED

If well telescopes please sketch and show depths.

GROUND LEVEL

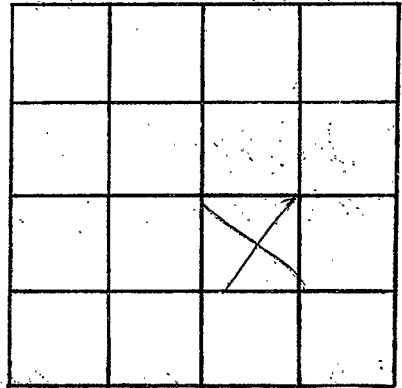

SECTION _____

Please indicate well location X.

ADDITIONAL INFORMATION

If more than one screen, show locations of each on sketch.