

MISSISSIPPI DEPARTMENT OF NATURAL RESOURCES

Bureau of Land and Water Resources

Southport Mall

P.O. Box 10631

Jackson, Mississippi 39209

WATER WELL DRILLERS LOG

<i>Gate</i>
<i>A 2038</i>
<i>8-14-80</i>

8-14-1980 date well completed *Bull Smith* firm name *Gate* county well located

LANDOWNER:
Eliza Carroll
Arkabutla, Miss.
(mailing address)

description of formations encountered	from	to
<i>top soil</i>	<i>0</i>	<i>5</i>
<i>gravel</i>	<i>5</i>	<i>90</i>
<i>sand</i>	<i>90</i>	<i>140</i>

WELL LOCATION:
sec *7* T *4* N R *9* E
92± miles *NW* of *Arkabutla*
(distance) (direction) (nearest town)

WELL PURPOSE:
(home) irrigation, municipal, industrial

WELL COMPLETION DATA:

(1) diameter (inches) ~~4"~~ *4"*

(2) total depth (feet) *140'*

(3) static water level (feet) *60* below above top of ground.

(4) casing *galv* *140'*
(material) (depth)

_____ if telescope see back.
(size)

(5) screen *20'* *120'*
(length) (depth to top)

4" *plastic*
(size) (material)

(6) pump *1/2* *10*
(HP) (yield gpm)

elec
(type power)

(7) electric log _____
(yes or no)

_____ (organization running log)

(8) how well bottom plugged *Cap*

DEPT. OF NATURAL RESOURCES
BUREAU OF LAND & WATER RESOURCES


SEP - 7 1982

RECEIVED

DRILLERS REMARKS:

If well telescopes please sketch and show depths.

GROUND LEVEL

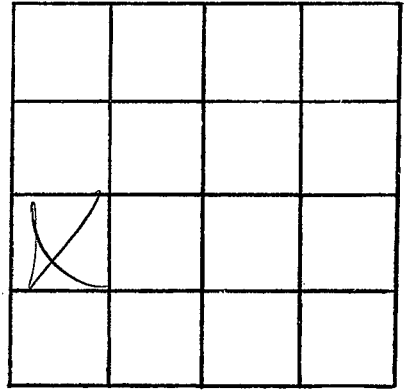

SECTION _____

Please indicate well location X.

ADDITIONAL INFORMATION

If more than one screen,
show locations of each on sketch.