

MISSISSIPPI DEPARTMENT OF NATURAL RESOURCES

Bureau of Land and Water Resources

Southport Mall

P.O. Box 10631

Jackson, Mississippi 39209

WATER WELL DRILLERS LOG

Tate
 A 2082
 10-23-80

Tate

10-23-80
 date well completed

Bob Smith
 firm name

Wet
 county well located

LANDOWNER:

Clair Smith
 (mailing address)

description of formations encountered

from to

top soil	0	5
red clay	5	20
white clay	20	70
gravel	70	120
white sand	120	190

WELL LOCATION:

sec. 14 T 4 N R 9 E
 7 miles North of Arkabutla
 (distance) (direction) (nearest town)

WELL PURPOSE:

(home, irrigation, municipal, industrial)

WELL COMPLETION DATA:

- (1) diameter (inches) 4"
- (2) total depth (feet) 190'
- (3) static water level (feet) 70' below top of ground.
- (4) casing plastic 190' (material) (depth)
- (size) if telescope see back.
- (5) screen 10' 180' (length) (depth to top)
 4" plastic (size) (material)
- (6) pump 1/2 5 (HP) (yield gpm)
 elec. (type power)
- (7) electric log (yes or no)
- (organization running log)
- (8) how well bottom plugged cap

DEPT. OF NATURAL RESOURCES
 BUREAU OF LAND & WATER RESOURCES


SEP - 7 1982

RECEIVED

DRILLERS REMARKS:

If well telescopes please sketch and show depths.

GROUND LEVEL

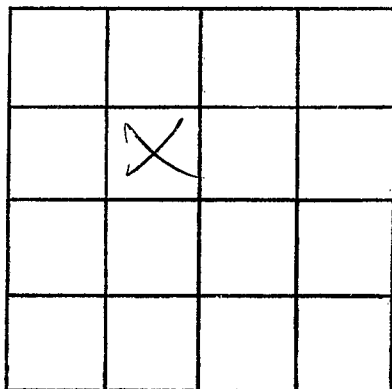

SECTION _____

Please indicate well location X.

ADDITIONAL INFORMATION

If more than one screen,
show locations of each on sketch.