

MISSISSIPPI DEPARTMENT OF NATURAL RESOURCES

Bureau of Land and Water Resources

Southport Mall

P.O. Box 10631

Jackson, Mississippi 39209

WATER WELL DRILLERS LOG

TATE
A 2040
7-30-81

7-30 19 81
date well completed

HICKS WELL CO.
P.O. Box 157
Senatobia, MS 38668

Tate
county well located

LANDOWNER: Dustin Laughlin
P.O. Box 3
Hicksville, MS.
(mailing address)

description of formations encountered	from	to
<u>Brown sand</u>	<u>0</u>	<u>50</u>
<u>White sand</u>	<u>50</u>	<u>135</u>

WELL LOCATION:
sec. 24 T 4 N R 9 E
1/2 miles NW of Hicksville
(distance) (direction) (nearest town)

WELL PURPOSE: Home
(home, irrigation, municipal, industrial)

- WELL COMPLETION DATA:
- (1) diameter (inches) 4
 - (2) total depth (feet) 135
 - (3) static water level (feet) 80 below above top of ground.
 - (4) casing PVC, 135
(material) (depth)
 - if telescope see back.
(size)
 - (5) screen 7, 128
(length) (depth to top)
 - 1/2", gravel type
(size) (material)
 - (6) pump 1/2, 18
(HP) (yield gpm)
 - 220V
(type power)
 - (7) electric log No
(yes or no)


(organization running log)

(8) how well bottom plugged Cap

DRILLERS REMARKS:

If well telescopes please sketch and show depths.

GROUND LEVEL

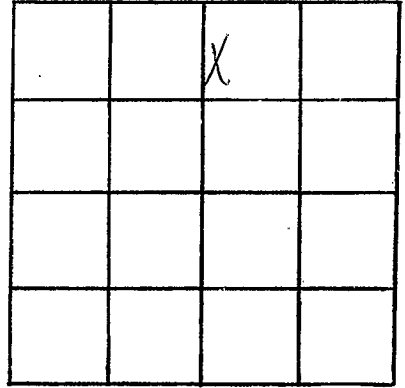

SECTION 24

Please indicate well location X.

ADDITIONAL INFORMATION

If more than one screen,
show locations of each on sketch.