

MISSISSIPPI DEPARTMENT OF NATURAL RESOURCES

Bureau of Land and Water Resources

Southport Mall

P.O. Box 10631

Jackson, Mississippi 39209

WATER WELL DRILLERS LOG
HICKS WELL CO.

Rt. 1, Box 157

Senatobia, MS 38668

Tate

Date
A 2042
7-31-81

17-31 19 81
date well completed

county well located

LANDOWNER: *Wiggins, Eugene*
P.O. Box 3

Rehabulla, Mo.
(mailing address)


description of formations encountered	from	to
<i>Brown sand</i>	<i>0</i>	<i>10</i>
<i>White sand</i>	<i>50</i>	<i>118</i>

WELL LOCATION:
sec. 24 T 4 N R 9 E
4 miles NE of Rehabulla
(distance) (direction) (nearest town)

WELL PURPOSE: *HOME*
(home, irrigation, municipal, industrial)


- WELL COMPLETION DATA:
- (1) diameter (inches) 4
 - (2) total depth (feet) 118
 - (3) static water level (feet) 50 below above top of ground.
 - (4) casing PVC, 118
(material) (depth)
 - If telescope see back.
(size)
 - (5) screen 7, 111
(length) (depth to top)
 - PVC, gravel tube
(size) (material)
 - (6) pump 1/2, 10
(HP) (yield gpm)
 - 220V
(type power)
 - (7) electric log As
(yes or no)
 - (organization running log)
 - (8) how well bottom plugged Cap

DRILLERS REMARKS:

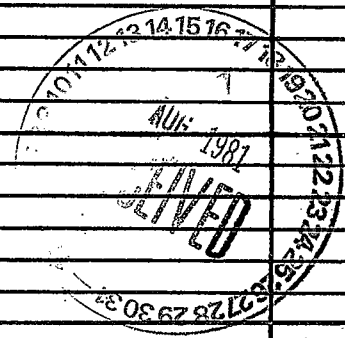

If well telescopes please sketch and show depths.

GROUND LEVEL

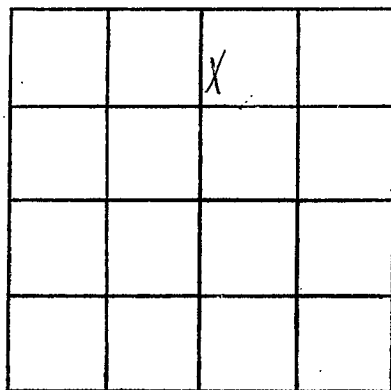

SECTION 24

Please indicate well location X.

ADDITIONAL INFORMATION

If more than one screen,
show locations of each on sketch.