

MISSISSIPPI DEPARTMENT OF NATURAL RESOURCES

Bureau of Land and Water Resources

Southport Mall

P.O. Box 10631

Jackson, Mississippi 39209

WATER WELL DRILLERS LOG

HICKS WELL COMPANY

TATE  
A 2013  
12/30/81

12-30 1981  
date well completed

BOX 157  
firm name

Tate  
county well located

LANDOWNER: Celestine Dye  
Rt. 1  
Coldwater, Ms. 38618  
(mailing address)

description of formations encountered	from	to
Red Clay	0	20
Black Clay	20	45
Gravel	45	60
White Sand	60	80
Black Clay	80	125

WELL LOCATION:  
sec. 28 T. 4 N. R. 9 E.  
2 miles NW of Ash Grove  
(distance) (direction) (nearest town)

WELL PURPOSE: Home  
(home, irrigation, municipal, industrial)


- WELL COMPLETION DATA:
- (1) diameter (inches) 4
  - (2) total depth (feet) 125
  - (3) static water level (feet) 60 below top of ground.
  - (4) casing PVC, 125 (material) (depth)
  - (5) screen 17' length, 108 (depth to top)  
14" (size) PVC-slotted (material)
  - (6) pump 1/2 (HP) 5 (yield gpm)  
220V (type power)
  - (7) electric log No (yes or no)
  - (8) how well bottom plugged Cap

DRILLERS REMARKS:

DEPT. OF NATURAL RESOURCES  
BUREAU OF LAND & WATER RESOURCES  
JAN 4 1982  
RECEIVED

If well telescopes please sketch and show depths.

GROUND LEVEL

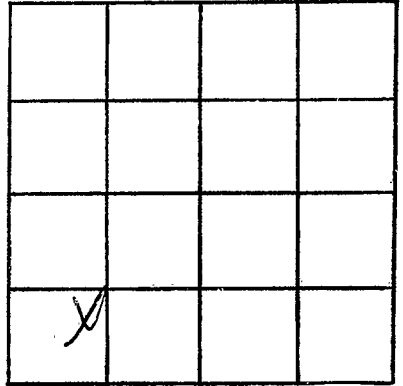

SECTION 28

Please indicate well location X.

ADDITIONAL INFORMATION

Lined area for additional information.

RECEIVED  
A 8:42  
81 JAN 4

If more than one screen, show locations of each on sketch.