

MISSISSIPPI DEPARTMENT OF NATURAL RESOURCES

Bureau of Land and Water Resources

Southport Mall

P.O. Box 10631

Jackson, Mississippi 39209

WATER WELL DRILLERS LOG

TATE

Date
A 2043
5-14-81

5-14-81 19 Bob Smith Tate  
 date well completed firm name county well located

LANDOWNER:	description of formations encountered	from	to
<u>Non Whitehead</u>	<u>top soil</u>	<u>0</u>	<u>5</u>
<del>Whitehead</del>	<u>course sand</u>	<u>5</u>	<u>30</u>
<del>Whitehead</del>	<u>red clay</u>	<u>30</u>	<u>90</u>
<u>Whitehead</u>	<u>white sand</u>	<u>90</u>	<u>103</u>
WELL LOCATION: sec. <u>15</u> T. <u>40</u> N. R. <u>9</u> E. <u>W</u> <u>2</u> miles <u>North</u> of <u>Arkabutla</u> (distance) (direction) (nearest town)			
WELL PURPOSE: <u>(home, irrigation, municipal, industrial)</u>			
WELL COMPLETION DATA: (1) diameter (inches) <u>4 1/2</u> (2) total depth (feet) <u>103</u> (3) static water level (feet) <u>60</u> <u>below</u> above top of ground. (4) casing <u>plastic 103'</u> (material) (depth) _____ if telescope see back. (size) (5) screen <u>20'</u> <u>83'</u> (length) (depth to top) <u>4"</u> <u>plastic</u> (size) (material) (6) pump <u>1/2</u> <u>10</u> (HP) (yield gpm) <u>elec</u> (type power) (7) electric log _____ (yes or no) _____ (organization running log) (8) how well bottom plugged <u>cup</u>			
DRILLERS REMARKS:			


DEPT. OF NATURAL RESOURCES  
BUREAU OF LAND & WATER RESOURCES

SEP -7 1982

RECEIVED

If well telescopes please sketch and show depths.

GROUND LEVEL

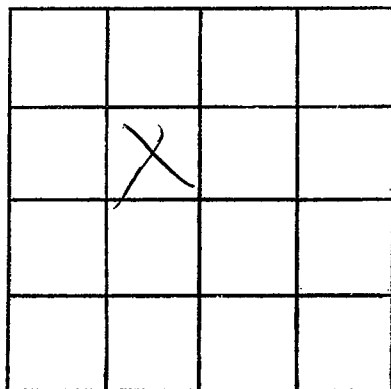

SECTION \_\_\_\_\_

Please indicate well location X.

ADDITIONAL INFORMATION

If more than one screen,  
show locations of each on sketch.