

MISSISSIPPI DEPARTMENT OF NATURAL RESOURCES

Bureau of Land and Water Resources

Southport Mall

P.O. Box 10631

Jackson, Mississippi 39209

WATER WELL DRILLERS LOG

Date
A 2044
2-15-82

2-15-82
date well completed

Bob Smith
firm name

Fate
county well located

LANDOWNER:
Russell Smith
Orkaletha, Ms
(mailing address)

description of formations encountered	from	to
top soil	0	5
red clay	5	25
gravel	25	100
sand	100	135

WELL LOCATION:
sec 38 T-4 N R-9 E
3 miles North of Orkaletha
(distance) (direction) (nearest town)

WELL PURPOSE:
(home, irrigation, municipal, industrial)

- WELL COMPLETION DATA:
- (1) diameter (inches) 4 1/2
 - (2) total depth (feet) 135
 - (3) static water level (feet) 80 below above top of ground.
 - (4) casing plastic 135' (material) (depth)
 - _____ if telescope see back. (size)
 - (5) screen 20' 110' (length) (depth to top)
 - 4" plastic (size) (material)
 - (6) pump 1/2 10 (HP) (yield gpm)
 - elec (type power)
 - (7) electric log yes no
 - _____ (organization running log)
 - (8) how well bottom plugged Cap

DRILLERS REMARKS:


DEPT. OF NATURAL RESOURCES
BUREAU OF LAND & WATER RESOURCES

SEP - 7 1982

RECEIVED

If well telescopes please sketch and show depths.

GROUND LEVEL

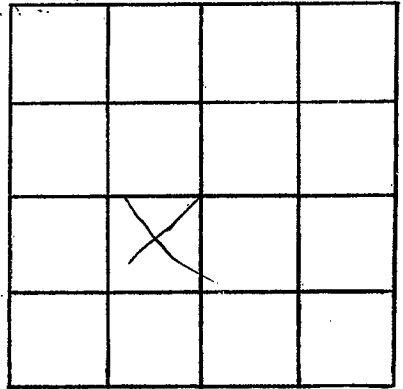

SECTION _____

Please indicate well location X.

ADDITIONAL INFORMATION

If more than one screen, show locations of each on sketch.