

MISSISSIPPI DEPARTMENT OF NATURAL RESOURCES

Bureau of Land and Water Resources

Southport Mall

P.O. Box 10631

Jackson, Mississippi 39209

WATER WELL DRILLERS LOG

late
A 2046
6-17-82

late

6-17-82 19 Bob Smith Bob Smith
 date well completed firm name county well located

| LANDOWNER: | description of formations encountered | from | to |
|--|---------------------------------------|------------|------------|
| <u>Robert McFee</u> | | | |
| <u>Arkabutla, Miss.</u> (mailing address) | <u>red clay</u> | <u>5</u> | <u>28</u> |
| | <u>white clay</u> | <u>28</u> | <u>72</u> |
| | <u>gravel</u> | <u>72</u> | <u>140</u> |
| | <u>sand</u> | <u>140</u> | <u>155</u> |

WELL LOCATION:
 sec 23 T-4 N R-9 E
4 miles North of Arkabutla
 (distance) (direction) (nearest town)

WELL PURPOSE:
 (home, irrigation, municipal, industrial)

- WELL COMPLETION DATA:
- (1) diameter (inches) _____
 - (2) total depth (feet) 155'
 - (3) static water level (feet) 85 below above top of ground.
 - (4) casing (material) 105' (depth)
 - _____ if telescope see back. (size)
 - (5) screen 20 135' (length) (depth to top)
 - _____ (size) _____ (material)
 - (6) pump 10 10 (HP) (yield gpm)
 - elec. (type power)
 - (7) electric log (yes or no)
 - _____ (organization running log)
 - (8) how well bottom plugged Cap.

DEPT. OF NATURAL RESOURCES
 BUREAU OF LAND & WATER RESOURCES


SEP - 7 1982

RECEIVED

DRILLERS REMARKS:

If well telescopes please sketch and show depths.

GROUND LEVEL

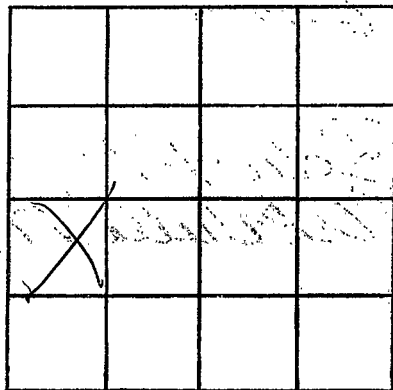

SECTION _____

Please indicate well location X.

ADDITIONAL INFORMATION

If more than one screen, show locations of each on sketch.