

MISSISSIPPI DEPARTMENT OF NATURAL RESOURCES

Bureau of Land and Water Resources

Southport Mall

P.O. Box 10631

Jackson, Mississippi 39209

WATER WELL DRILLERS LOG

TATE
A 2048
6-26-82

Tate

6-26-82¹⁹ *Bob Smith* *Madison*
date well completed firm name county well located

LANDOWNER:	description of formations encountered	from	to
<i>A. Campbell</i>			
<i>Okalutla (M)</i>	<i>red clay</i>	<i>5</i>	<i>80</i>
(mailing address)	<i>white sandy</i>	<i>80</i>	<i>100</i>
	<i>gravel</i>	<i>100</i>	<i>130</i>
	<i>sand</i>	<i>130</i>	<i>135</i>

WELL LOCATION:
sec 23 T 4 N 5 R 9 E W
5 miles North Okalutla
(distance) (direction) (nearest town)

WELL PURPOSE:
(home, irrigation, municipal, industrial)

WELL COMPLETION DATA:

(1) diameter (inches) 4"

(2) total depth (feet) 135'

(3) static water level (feet) 80' below above top of ground.

(4) casing plastic, 135'
(material) (depth)
____ if telescope see back.
(size)

(5) screen 20, 115'
(length) (depth to top)
1/2", plastic
(size) (material)

(6) pump 1/2 10
(HP) (yield gpm)
elec
(type power)

(7) electric log (yes or no)
(organization running log)

(8) how well bottom plugged Cap

DRILLERS REMARKS:


DEPT. OF NATURAL RESOURCES
BUREAU OF LAND & WATER RESOURCES

SEP -7 1982

RECEIVED

If well telescopes please sketch and show depths.

GROUND LEVEL

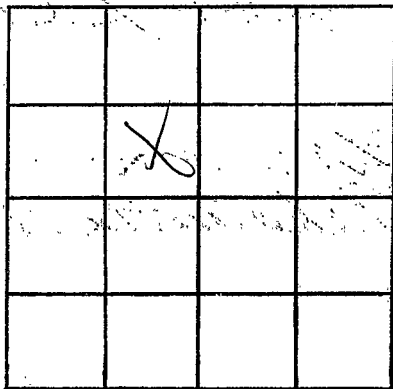

SECTION _____

Please indicate well location X.

ADDITIONAL INFORMATION

If more than one screen,
show locations of each on sketch.