

MISSISSIPPI DEPARTMENT OF NATURAL RESOURCES

Bureau of Land and Water Resources

Southport Mall

P.O. Box 10631

Jackson, Mississippi 39209

WATER WELL DRILLERS LOG

HICKS WELL CO.

Rt. 1, Box 157

Senatobia, MS 38668

Date
Aug 20 1983

9-23 19 83
 date well completed

Tate
 county well located

LANDOWNER: Rosetta Lile
Rt. 1 Box 593

description of formations encountered

from to

Caldwell, Miss
 (mailing address)

Red Clay 0 10

Red Sand + Gravel 10 65

WELL LOCATION:
 sec. 9 T 4 N R 9 E
4 miles NW of Senatobia
 (distance) (direction) (nearest town)

Black Clay 65 125

White Sand 125 155

WELL PURPOSE: Home
 (home, irrigation, municipal, industrial)

WELL COMPLETION DATA:

(1) diameter (inches) 4

(2) total depth (feet) 155

(3) static water level (feet) 80 below above top of ground.

(4) casing PVC, 155
 (material) (depth)

4"
 (size) if telescope see back.

(5) screen 10', 145'
 (length) (depth to top)

1013, PVC
 (size) (material)

(6) pump 1/2, 10
 (HP) (yield gpm)

220V
 (type power)

(7) electric log No
 (yes or no)

(organization running log)

(8) how well bottom plugged Cap

DRILLERS REMARKS:


DEPT. OF NATURAL RESOURCES
 BUREAU OF LAND & WATER RESOURCES

OCT 13 1983

RECEIVED

If well telescopes please sketch and show depths.

GROUND LEVEL

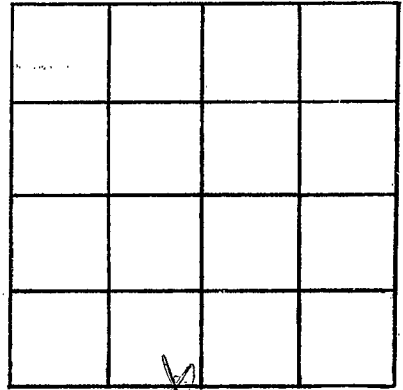

SECTION 9

Please indicate well location X.

ADDITIONAL INFORMATION

If more than one screen,
show locations of each on sketch.