

MISSISSIPPI DEPARTMENT OF NATURAL RESOURCES

Bureau of Land and Water Resources

Southport Mall

P.O. Box 10631

Jackson, Mississippi 39209

WATER WELL DRILLERS LOG

Date  
A 2029

3-16 1983 date well completed  
 HICKS WELL CO. Pt. 1, Box 157 Senatobia, MS 38668  
 county well located Tas

LANDOWNER: Johnny Allison  
R-1 B-592  
Caldwate, Miss. 38618  
 (mailing address)

description of formations encountered	from	to
<u>Red clay</u>	<u>0</u>	<u>10</u>
<u>Red sand</u>	<u>10</u>	<u>20</u>
<u>Yellow sand</u>	<u>20</u>	<u>40</u>
<u>White sand</u>	<u>40</u>	<u>82</u>

WELL LOCATION:  
 sec. 9 T 4 N R. 9 E  
5 miles NW of Shobatch  
 (distance) (direction) (nearest town)

WELL PURPOSE: Home  
 (home, irrigation, municipal, industrial)

WELL COMPLETION DATA:

(1) diameter (inches) 4

(2) total depth (feet) 82

(3) static water level (feet) 30 <sup>below</sup> / <sub>above</sub> top of ground.

(4) casing PVC, 82  
 (material) (depth)  
4" if telescope see back.  
 (size)

(5) screen 15x 67  
 (length) (depth to top)  
013, PVC  
 (size) (material)

(6) pump 1/2 10  
 (HP) (yield gpm)  
220V  
 (type power)

(7) electric log No  
 (yes or no)  
 (organization running log)

(8) how well bottom plugged Cap

DRILLERS REMARKS:


DEPT. OF NATURAL RESOURCES  
 BUREAU OF LAND & WATER RESOURCES

MAR 23 1983

RECEIVED

If well telescopes please sketch and show depths.

GROUND LEVEL

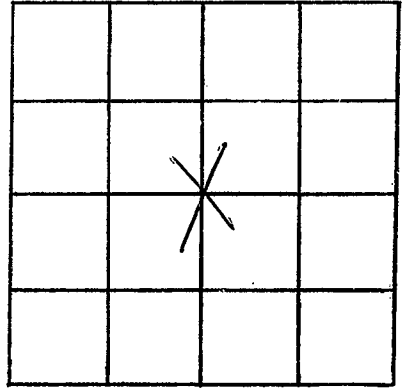

SECTION 9

Please indicate well location X.

ADDITIONAL INFORMATION

If more than one screen,  
show locations of each on sketch.