

MISSISSIPPI DEPARTMENT OF NATURAL RESOURCES
 Bureau of Land and Water Resources
 Southport Mall
 P.O. Box 10631
 Jackson, Mississippi 39209

WATER WELL DRILLERS LOG

Date
A 2050

7-7 1983
 date well completed

HICKS WELL CO.
 Rt. 1, Box 157
 Senatobia, MS 38668

Tate
 county well located

LANDOWNER: Eddie Thompson
Box 711
Caldwate, Ms. 38618
 (mailing address)

description of formations encountered	from to	
	from	to
<u>Red Clay</u>	<u>0</u>	<u>20</u>
<u>Red Sand</u>	<u>20</u>	<u>60</u>
<u>White Sand</u>	<u>60</u>	<u>120</u>
<u>White Sand + Clay</u>	<u>120</u>	<u>140</u>

WELL LOCATION:
 sec 28 T 4 N R 9 E
2 miles W of Arkalutha
 (distance) (direction) (nearest town)

WELL PURPOSE: Home
 (home, irrigation, municipal, industrial)

- WELL COMPLETION DATA:
- (1) diameter (inches) 4
 - (2) total depth (feet) 140
 - (3) static water level (feet) 60 ^{below} above top of ground.
 - (4) casing PVC, 140,
 (material) (depth)
4"
 (size) if telescope see back.
 - (5) screen 10', ~~110'~~
 (length) (depth to top)
.013, PVC
 (size) (material)
 - (6) pump 1/2, 10
 (HP) (yield gpm)
220V
 (type power)
 - (7) electric log No
 (yes or no)

(organization running log)

(8) how well bottom plugged Cap

DRILLERS REMARKS:


DEPT. OF NATURAL RESOURCES
 BUREAU OF LAND & WATER RESOURCES

AUG 11 1983

RECEIVED

If well telescopes please sketch and show depths.

GROUND LEVEL

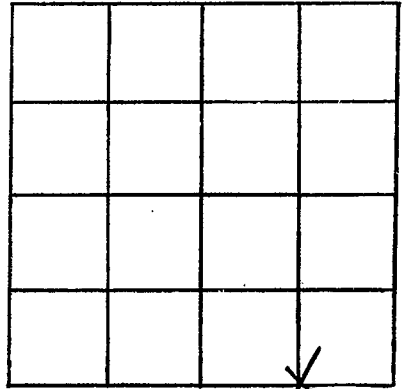

SECTION 28

Please indicate well location X.

ADDITIONAL INFORMATION

If more than one screen, show locations of each on sketch.