

MISSISSIPPI DEPARTMENT OF NATURAL RESOURCES

Bureau of Land and Water Resources

Southport Mall

P.O. Box 10631

Jackson, Mississippi 39209

WATER WELL DRILLERS LOG

Tate
A 2058
1-22-85

HICKS WELL COMPANY

1-22 1985
date well completed

RT. 1 - BOX 177
firm name

Tate
county well located

LANDOWNER: Martha Neyman

description of formations encountered

from

to

R#1 Caldwellwater MS

Red clay

0

20

Box 402 38618

Red Sand

20

40

(mailing address)

Black Clay

40

100

WELL LOCATION:

White Sand & Clay

100

130

sec. 26 T. 4 N. R. 9 E

White Sand

130

190

1 miles North of Arkabutla
(distance) (direction) (nearest town)

Black Clay

190

200

WELL PURPOSE: Home
(home, irrigation, municipal, industrial)

WELL COMPLETION DATA:

- (1) diameter (inches) 2 1/2"
- (2) total depth (feet) 200'
- (3) static water level (feet) 100' below top of ground.

- (4) casing PVC, 160' (material) (depth)
2 1/2" (size) if telescope see back.

- (5) screen 10' (length), 160' (depth to top)
1/2" (size), PVC (material)

- (6) pump 1/2 (HP), 10 (yield gpm)
220 v (type power)

- (7) electric log No (yes or no)
(organization running log)

- (8) how well bottom plugged Cap


RECEIVED
JUL 1 - 1985

DRILLERS REMARKS: At base
32 ft of Denham on it
& 10' of Denham

Department of Natural Resources
Bureau of Land & Water Resources

If well telescopes please sketch and show depths.

GROUND LEVEL

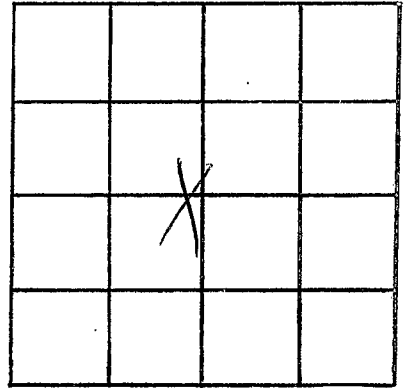

SECTION 26

Please indicate well location X.

ADDITIONAL INFORMATION

If more than one screen, show locations of each on sketch.