

MISSISSIPPI DEPARTMENT OF NATURAL RESOURCES

Bureau of Land and Water Resources

Southport Mall

P.O. Box 10631

Jackson, Mississippi 39209

WATER WELL DRILLERS LOG

Tate  
A 2035  
1-24-85

HICKS WELL COMPANY

Tate

1-24 19 85  
date well completed

RT. 1 - firm name  
SENATOBIA, MISS.

county well located

LANDOWNER: Todd Faller

Ac # 1 Box 434

Caldwater MS 38618  
(mailing address)

WELL LOCATION:

sec. 15 T 4 N R 9 E  
4 miles North of Arkabutla  
(distance) (direction) (nearest town)

WELL PURPOSE: Home  
(home, irrigation, municipal, industrial)

WELL COMPLETION DATA:

- (1) diameter (inches) 4"
- (2) total depth (feet) 155'
- (3) static water level (feet) 100' <sup>below</sup> above top of ground.
- (4) casing PVC, 145'  
(material) (depth)  
4" if telescope see back.  
(size)
- (5) screen 10', 145'  
(length) (depth to top)  
.010, PVC  
(size) (material)
- (6) pump 1/2, 10  
(HP) (yield gpm)  
220 V  
(type power)
- (7) electric log No  
(yes or no)  
(organization running log)
- (8) how well bottom plugged cap

description of formations encountered

from to

Red Clay	0	10
Red Sand	10	30
Gravel & Sand	30	50
White Sand	50	155


RECEIVED  
JUL 1 - 1985

DRILLERS REMARKS:

Department of Natural Resources  
Bureau of Land & Water Resources

If well telescopes please sketch and show depths.

GROUND LEVEL

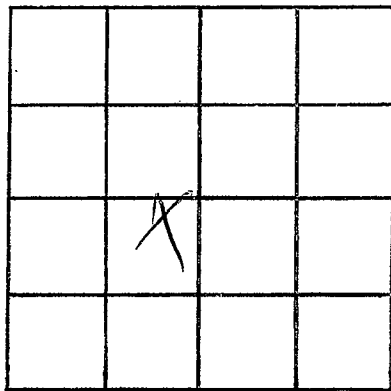

SECTION 15

Please indicate well location X.

ADDITIONAL INFORMATION

If more than one screen,  
show locations of each on sketch.