

MISSISSIPPI DEPARTMENT OF NATURAL RESOURCES

Bureau of Land and Water Resources

Southport Mall

P.O. Box 10631

Jackson, Mississippi 39209

WATER WELL DRILLERS LOG

Tate
A 2056
2-28-85

HICKS WELL COMPANY

Tate

2-28-1985
date well completed

RT. 1 - Box 106 Home

county well located

LANDOWNER: James Neal

description of formations encountered

from to

3997 Spiegel Dr.

Memphis TN 38116
(mailing address)

WELL LOCATION:

sec. 15 T 4 N R 9 E
(S) NW (W)
4 miles North of Arkabutla
(distance) (direction) (nearest town)

WELL PURPOSE: HOME
(home, irrigation, municipal, industrial)

WELL COMPLETION DATA:

- (1) diameter (inches) 4"
- (2) total depth (feet) 170'
- (3) static water level (feet) 100' below above top of ground.
- (4) casing PVC, 130' (material) (depth)
4" (size) if telescope see back.
- (5) screen 10' (length), 130' (depth to top)
10' (size), PVC (material)
- (6) pump 1/2 (HP), 10 (yield gpm)
220 V (type power)
- (7) electric log No (yes or no)
(organization running log)
- (8) how well bottom plugged Cap

DRILLERS REMARKS: It has 30 ft. of Deadman on it & 10 ft of screen


description of formations encountered	from	to
Red clay	0	10
Red Sand	10	30
White Sand & clay	30	130
White Sand	130	150
White Sand & clay	150	170

RECEIVED
JUL 1 - 1985

Department of Natural Resources
Bureau of Land & Water Resources

If well telescopes please sketch and show depths.

GROUND LEVEL

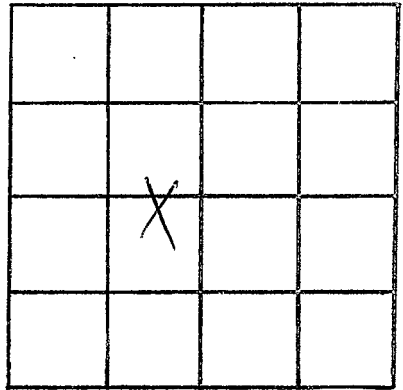

SECTION 15

Please indicate well location X.

ADDITIONAL INFORMATION

If more than one screen,
show locations of each on sketch.