

MISSISSIPPI DEPARTMENT OF NATURAL RESOURCES

Bureau of Land and Water Resources

P.O. Box 10631

Jackson, Mississippi 39209

WATER WELL DRILLERS LOG

COUNTY WELL LOCATED TATE	
WELL NUMBER A	CODED
DATE WELL COMPLETED 8-30-88	

PERMIT NUMBER	NAME OF DRILLING FIRM Hicks Drilling Co.
---------------	--

NAME & MAILING ADDRESS OF LANDOWNER Frank Grimes			
Rt. 1 Arkabutla			
Colburn, Ms. 38618			
WELL LOCATION:	SEC 26	TOWNSHIP 4	RANGE N 9 E
DISTANCE	DIRECTION	NEAREST TOWN	
1/2 Miles	N	of Arkabutla	
OTHER LANDMARK			
WELL PURPOSE: Home, Irrigation, Municipal, Industrial, Fish Pond, etc. Home			

PUMP DATA		
PUMP TYPE (Circle One): <u>Submersible</u> , Turbine, Jet, Flowing Well, Other (Describe)		
POWER TYPE (Circle One): Electric, Tractor, Diesel, Gasoline, Butane, Other (Describe)		
Pump Capacity (GPM) 10	No. of Stages 9	Setting Depth 150 FT.
PUMP TEST		
Well yielded _____ GPM with a drawdown of _____ ft. after _____ hours of pumping		

WELL DATA		
Well Depth 140	Casing Diameter (In.) 4	Casing Length (Ft.) 130
Type of Casing PVC	Hole Depth 140	Depth to Static Water Level 80
TYPE OF COMPLETION: (Circle One or More): <u>Natural Development</u> , Gravel Packed, Underreamed, Telescoped, Open Hole, Other (Describe)		
Top of Lap Pipe or Reduction in Casing		
FEET IF TELESCOPED OR MORE THAN ONE SCREEN: USE BACK PAGE		

LOG DATA	
TYPE OF LOG RUN (Circle One): Electric, Gamma Ray, Density, Sonic, Neutron, Other (Describe) <u>No Log Run</u>	
Name of Organization Running Log	

SCREEN DATA		
Diameter - Inches 4	Length - Feet 10	Slot Size - Inches .013
Screen Type PVC	Depth to Bottom - Feet 0	


GEOLOGIC DATA (Office Use Only)			
Surface Elev.	Geologic Unit	Unit Thickness	Depth to Top
Subs. SWL	Date	Analysis	Aquifer Test
Driller's Remarks			

DESCRIPTION OF FORMATIONS ENCOUNTERED	FROM	TO	FORMATIONS CONTINUED
Red clay	0	10	<div style="border: 2px solid black; padding: 5px; display: inline-block;"> RECEIVED SEP 14 1988 </div>
Red sand	10	30	
White clay	30	80	
White sand	80	140	

**Department of Natural Resources
Bureau of Land & Water**

If well telescopes please
sketch and show depths.

GROUND LEVEL

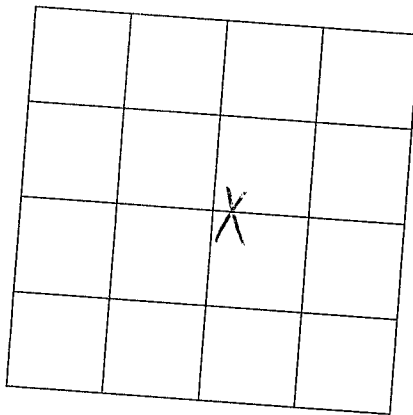

SECTION 26

Please indicate well location X.

ADDITIONAL INFORMATION

Lined area for additional information.

If more than one screen,
show location of each on sketch.