

MISSISSIPPI DEPARTMENT OF ENVIRONMENTAL QUALITY
Office of Land and Water Resources

P. O. Box 10631
 Jackson, MS 39289-0631
WATER WELL DRILLERS LOG

COUNTY WELL LOCATED TATE	
WELL NUMBER 3/8	CODED
A-20916	
DATE WELL COMPLETED 2-13-02	

PERMIT NUMBER
NAME OF DRILLING FIRM SMITH WELL DRILLING & SEW.

NAME & MAILING ADDRESS OF LANDOWNER BOBBY FORESTER			
PRITCHARD RD.			
COLUMBIAN, MS 38618			
WELL LOCATION:	SEC	TOWNSHIP	RANGE
	A-32	T-4	N-19
DISTANCE	DIRECTION	NEAREST TOWN	
5 Miles	W	of AMANTUA	
OTHER LANDMARK			
WELL PURPOSE: Home, Irrigation, Municipal, Industrial, Fish Pond, etc. Home			

PUMP DATA			
PUMP TYPE (Circle One): <input checked="" type="radio"/> Submersible, Turbine, Jet, Flowing Well, Other (Describe) _____			
POWER TYPE (Circle One): <input checked="" type="radio"/> Electric, Tractor, Diesel, Gasoline, Butane, Other (Describe) _____ H/P 34			
Pump Capacity (GPM)	No. of Stages	Setting Depth	
12	10	76 FT.	
PUMP TEST			
Well yielded 5 GPM with a drawdown of 6 ft. after 1 hours of pumping			

WELL DATA		
Well Depth 76	Casing Diameter (In.) 4"	Casing Length (Ft.) 56
Type of Casing PVC	Hole Depth 76	Depth to Static Water Level 70'
TYPE OF COMPLETION: (Circle One or More): Gravel Packed, Underreamed, Telescoped, Natural Development, Open Hole, Other (Describe) WASHED SAND		

LOG DATA	
TYPE OF LOG RUN (Circle One): <input type="radio"/> No Log Run, <input type="radio"/> Electric, <input type="radio"/> Gamma Ray, <input type="radio"/> Density, <input type="radio"/> Sonic, <input type="radio"/> Neutron, Other (Describe) _____	
Name of Organization Running Log	

WELL GROUTED TO A DEPTH OF 10 FEET Type Grout (circle one) <input checked="" type="radio"/> Cement, <input type="radio"/> Bentonite, or Mix

GEOLOGIC DATA (Office Use Only)			
Surface Elev.	Geologic Unit	Unit Thickness	Depth to Top
Subs. SWL	Date	Analysis	Aquifer Test

SCREEN DATA			
Diameter - Inches 4"	Length - Feet 20	Slot Size - Inches 1470005	
Screen Type: PVC	Depth to Bottom - Feet 76		


Driller's Remarks	
Top of Lap Pipe or Reduction in Casing	
FEET	IF TELESCOPED OR MORE THAN ONE SCREEN: USE BACK PAGE

DESCRIPTION OF FORMATIONS ENCOUNTERED	FROM	TO
TOP SOIL	0	20
WHITE CLAY	20	63
RED CLAY & SAND	63	76
GRAY CLAY	76	

FORMATIONS (Continued)	FROM	TO
RECEIVED		
AUG 22 2002		
BY: OLWR		

If well telescopes please
sketch and show depths.

GROUND LEVEL

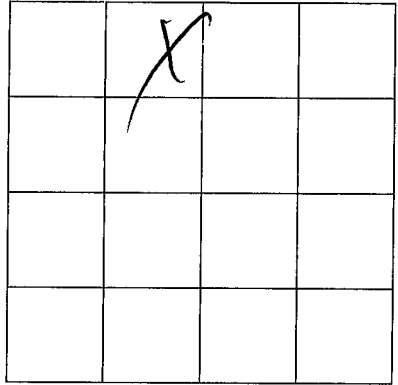

SECTION *A-32*

Please indicate well location X.

ADDITIONAL INFORMATION

If more than one screen,
show location of each on sketch.