

**MISSISSIPPI
BOARD OF WATER COMMISSIONERS**
416 North State Street
Jackson, Mississippi 39201

WATER WELL DRILLERS LOG

Date
B D 56
9-68
UGES

Sept. 68 Robert E. Ratloff Date
date well completed firm name county well located

LANDOWNER: Jarvis of
Caldwater, Miss


description of formations encountered	from	to
Red Clay	0	15
Fine red sand	15	30
Clay gravel	30	46
Clay	46	94
Coarse sand	94	159
Clay	159	202

(mailing address)

WELL LOCATION:
sec. 31 T. 4 N. R. 7 E.
0 miles in Jarvis of Jarvis
(distance) (direction) (nearest town)

WELL PURPOSE: Municipal
(home, irrigation, municipal, industrial)

- WELL COMPLETION DATA:
- (1) diameter (inches) 20x12
 - (2) total depth (feet) 158'
 - (3) static water level (feet) 58' ^{below} _{above} top of ground
 - (4) casing Bl. st. 98' x 20"
(material) (depth)
106' 3/2" epoxy coated
(size) ^{telescope see back}
 - (5) screen 52' 106'
(length) (depth to top)
12" st. steel
(size) (material)
 - (6) pump 15 1220 o.d.
(HP) (yield gpm)
Electric
(type power)
 - (7) electric log yes
(yes or no)
El. & G.A.
(organization running log)
 - (8) how well bottom plugged BPU

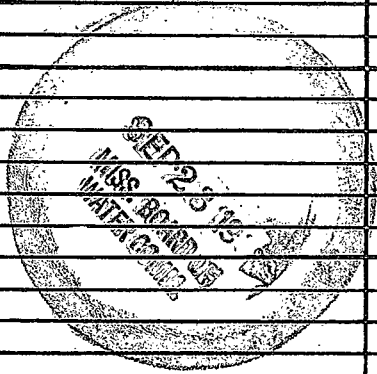

DRILLERS REMARKS:


If well telescopes please sketch and show depths.

GROUND LEVEL

98'
g
20"

106'
g
12"

52'
g
12"
Screen

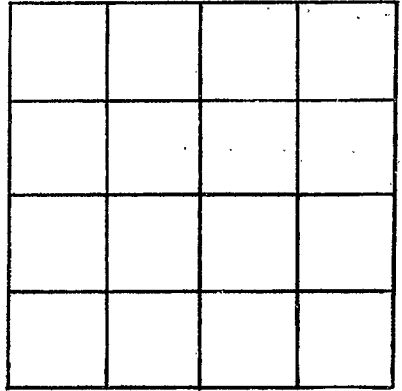

SECTION _____

Please indicate well location X.

ADDITIONAL INFORMATION

Lined area for additional information.

If more than one screen, show locations of each on sketch.