

Fate
 B7
 6-15-68

MISSISSIPPI
 BOARD OF WATER COMMISSIONERS
 416 North State Street
 Jackson, Mississippi 39201

CODED

WATER WELL DRILLERS LOG

6-15 1968 Harris Bros. Fate
 date well completed firm name county well located

LANDOWNER: A.B. Calaman

description of formations encountered	from	to
top soil	0	20
gravel	20	45
clay	45	85
clay + sand	85	130
W. sand	130	154

Rto 2.
 Caldwellwater
 (mailing address)

WELL LOCATION:
 sec 27 T 4 N R 7 E
 4 miles E of Caldwellwater
 (distance) (direction) (nearest town)

WELL PURPOSE: none
 (home, irrigation, municipal, industrial)

- WELL COMPLETION DATA:
- (1) diameter (inches) 4
 - (2) total depth (feet) 154
 - (3) static water level (feet) 120 below top of ground.
 - (4) casing Plastic 140 (material) (depth)
 4" if telescope see back. (size)
 - (5) screen 14" (length), 140 (depth to top)
 1/2" Plastic (size) (material)
 - (6) pump 3/4 (HP), 10 (yield gpm)
 elec (type power)
 - (7) electric log no (yes or no)

CODED

(organization running log)

(8) how well bottom plugged
 brush
 not


MAR 7 1969

DRILLERS REMARKS:

MISS. BD. OF WATER COMM.

If well telescopes please sketch and show depths.

GROUND LEVEL

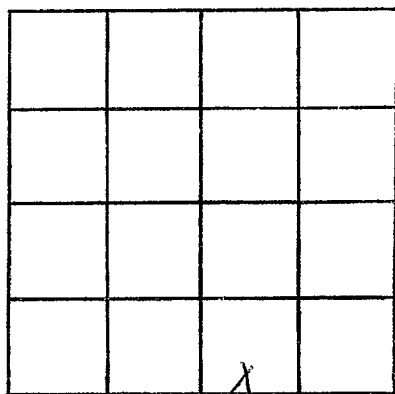

SECTION 27

Please indicate well location X.

ADDITIONAL INFORMATION

If more than one screen,
show locations of each on sketch.