

CODED

MISSISSIPPI
BOARD OF WATER COMMISSIONERS
416 North State Street
Jackson, Mississippi 39201

WATER WELL DRILLERS LOG

Date
B 13
5-22-69

5-22-1969 date well completed Harris Bros. firm name Tate county well located

LANDOWNER: Mrs. Sterling a. Massey ste 2 Coldwater (mailing address)	description of formations encountered	from	to
	top soil	0	20
	white clay	20	50
	clay + fine sand	50	120
	coarse sand	120	140

WELL LOCATION:
sec 26 T 4 N R 7 E
7 miles E of Coldwater
(distance) (direction) (nearest town)

WELL PURPOSE: none
(home, irrigation, municipal, industrial)

WELL COMPLETION DATA:

(1) diameter (inches) 4"

(2) total depth (feet) 140'

(3) static water level (feet) 100' below top of ground.

(4) casing Plastic, 133' (material) (depth)
4" (size) if telescope see back.

(5) screen 7' length, 133' (depth to top)
008 Plastic (size) (material)

(6) pump 74 (HP) 7 (yield gpm)
elec. (type power)

(7) electric log No (yes or no)

(organization running log)


(8) how well bottom plugged much shot

DRILLERS REMARKS:

DEC 22 1969
MISS. Bd. of WATER COMMISSIONERS

If well telescopes please sketch and show depths.

GROUND LEVEL

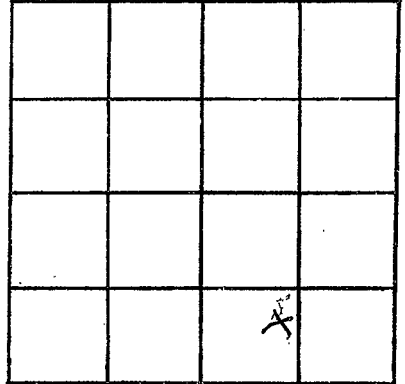

SECTION 26

Please indicate well location X.

ADDITIONAL INFORMATION

If more than one screen, show locations of each on sketch.