

TATE
R 14
6-17-69

MISSISSIPPI
BOARD OF WATER COMMISSIONERS
416 North State Street
Jackson, Mississippi 39201

CODED

WATER WELL DRILLERS LOG

6-17 1969 Harris Bros. Tate
date well completed firm name county well located

LANDOWNER: Karl H. Parks
Rto 3
Coldwater
(mailing address)

description of formations encountered	from	to
top soil	0	65
red red clay + sand	15	45
fine sand	45	70
sand + clay	70	120
course sand	120	135

WELL LOCATION:
sec 33 T 4 N R 7 E
3 miles E of Coldwater
(distance) (direction) (nearest town)

WELL PURPOSE: home
(home, irrigation, municipal, industrial)


- WELL COMPLETION DATA:
- (1) diameter (inches) 4"
 - (2) total depth (feet) 135
 - (3) static water level (feet) 80 below top of ground.
 - (4) casing Plastic, 128'
(material) (depth)
4" if telescope see back.
(size)
 - (5) screen 7, 128
(length) (depth to top)
.008 Plastic
(size) (material)
 - (6) pump 3/4, 7
(HP) (yield gpm)
elc
(type power)
 - (7) electric log no
(yes or no)
- (organization running log)
- (8) how well bottom plugged back
shuts

DRILLERS REMARKS:

DEC 22 1969
MISS. BO. OF
WATER COM.

If well telescopes please sketch and show depths.

GROUND LEVEL

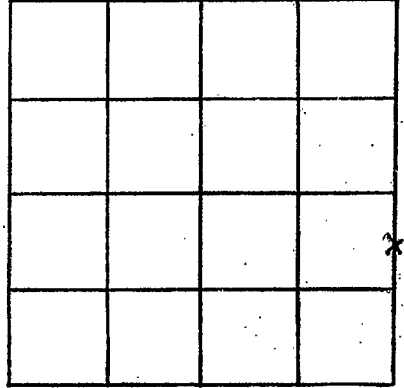

SECTION 33

Please indicate well location X.

ADDITIONAL INFORMATION

If more than one screen,
show locations of each on sketch.