

MISSISSIPPI  
BOARD OF WATER COMMISSIONERS  
416 North State Street  
Jackson, Mississippi 39201

WATER WELL DRILLERS LOG

TATE  
B 15  
9-15-69

9-15 1969 date well completed  
Harris Bros. firm name  
Tate county well located

LANDOWNER: George Thomas  
Rte 3  
Coldwater  
(mailing address)  
WELL LOCATION:  
sec 24 T 4 N R 7 E  
9 miles NW of Clintense  
(distance) (direction) (nearest town)

description of formations encountered	from	to
top soil	0	20
sand & gravel	20	75
clay & sand	75	120
course sand	120	140

WELL PURPOSE: home  
(home, irrigation, municipal, industrial)

WELL COMPLETION DATA:  
(1) diameter (inches) 4"  
(2) total depth (feet) 140  
(3) static water level (feet) 80 below top of ground.  
(4) casing Plastic, 133'  
(material) (depth)  
4 if telescope see back.  
(size)  
(5) screen 7', 133'  
(length) (depth to top)  
008, Plastic  
(size) (material)  
(6) pump 3/4, 7  
(HP) (yield gpm)  
elec.  
(type power)  
(7) electric log no  
(yes or no)  
(organization running log)

(8) how well bottom plugged much  
shot


DRILLERS REMARKS:

DEC 20 1969

MISS. DIV. OF WATER RESOURCES

If well telescopes please sketch and show depths.

GROUND LEVEL

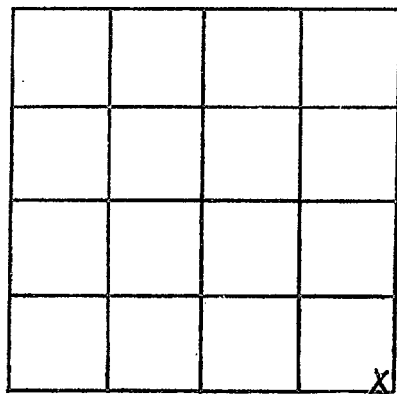

SECTION 24

Please indicate well location X.

ADDITIONAL INFORMATION

If more than one screen, show locations of each on sketch.