

MISSISSIPPI  
 BOARD OF WATER COMMISSIONERS  
 416 North State Street  
 Jackson, Mississippi 39201

CODED

WATER WELL DRILLERS LOG

TATE  
 B 16  
 10-2-69

10-2 1969 Harris Bros. Tate  
 date well completed firm name county well located

| LANDOWNER: R. B. Coleman<br>Rte. 3<br>Coldwater<br>(mailing address) | description of formations encountered | from | to  |
|--|---------------------------------------|------|-----|
|  | top soil                              | 0    | 20  |
|  | sand & gravel                         | 20   | 70  |
|  | sand & clay                           | 70   | 120 |
|  | coarse sand                           | 120  | 140 |

WELL LOCATION:  
 sec 24 T 4 N R 7 E  
 9 miles NW of Clarksburg  
 (distance) (direction) (nearest town)

WELL PURPOSE: home  
 (home, irrigation, municipal, industrial)

WELL COMPLETION DATA:

(1) diameter (inches) 4"  
 (2) total depth (feet) 140'  
 (3) static water level (feet) 80' below top of ground.  
 (4) casing Plastic, 133' (material) (depth)  
 4" (size) if telescope see back.  
 (5) screen 7' 133' (length) (depth to top)  
 008 Plastic (size) (material)  
 (6) pump 7/4 7 (HP) (yield gpm)  
 elec. (type power)  
 (7) electric log no (yes or no)  
 (organization running log)  
 (8) how well bottom plugged brass  
 spot


DRILLERS REMARKS:

DEC 29 1969

MISC. DD. 65  
 WATER COMM.

If well telescopes please sketch and show depths.

GROUND LEVEL

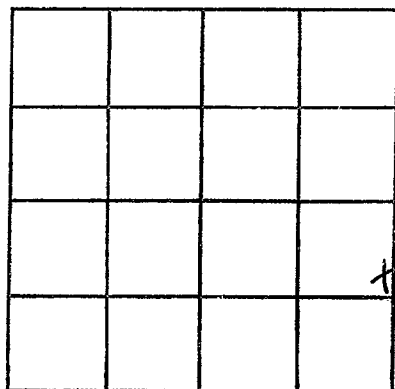

SECTION 24

Please indicate well location X.

ADDITIONAL INFORMATION

If more than one screen, show locations of each on sketch.