

Tate Co
 B 17
 2-6-70

MISSISSIPPI
 BOARD OF WATER COMMISSIONERS
 416 North State Street
 Jackson, Mississippi 39201

WATER WELL DRILLERS LOG

CODED

2-6 1970 Harris Bros Tate
 date well completed firm name county well located

LANDOWNER: Virgil Jensen
 Rt. 1, Box 37
 Coldwater
 (mailing address)

description of formations encountered	from	to
top soil	0	20
fine sand & clay	20	75
fine sand	75	120
gray clay	120	145
coarse sand	145	170

WELL LOCATION:
 sec. 32 T 4 N R. 8 E
 3 miles E of Okahatche
 (distance) (direction) (nearest town)

WELL PURPOSE: home
 (home, irrigation, municipal, industrial)

- WELL COMPLETION DATA:
- diameter (inches) 4"
 - total depth (feet) 170'
 - static water level (feet) 90' below top of ground.
 - casing Plastic, 156' (material) (depth)
 4" (size) if telescope see back.
 - screen 14' (length) 156' (depth to top)
 100 (size) Plastic (material)
 - pump 3/4 (HP) 7 (yield gpm)
 elec. (type power)
 - electric log NO (yes or no)
 (organization running log)
 - how well bottom plugged much shot

CODED


MAR 25 1970

DRILLERS REMARKS:

MISS. BD. OF
 WATER COMM.

If well telescopes please sketch and show depths.

GROUND LEVEL

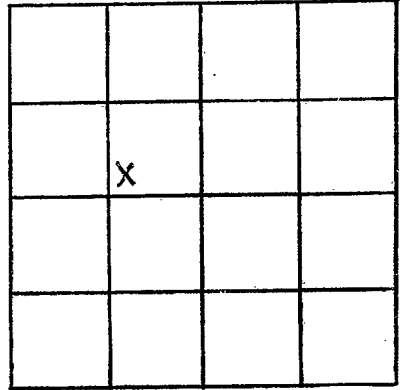

SECTION 32

Please indicate well location X.

ADDITIONAL INFORMATION

If more than one screen,
show locations of each on sketch.