

MISSISSIPPI
BOARD OF WATER COMMISSIONERS
416 North State Street
Jackson, Mississippi 39201

CODED

WATER WELL DRILLERS LOG

TATE
B21
5-23-70

5-23 19 70 Bob Smith Tate
date well completed firm name county well located

LANDOWNER: Wright
Andygarden, Minn.
(mailing address)
WELL LOCATION:
sec. 25 T. 4 N. R. 7 E. 213
6 miles W of IND
(distance) (direction) (nearest town)

description of formations encountered	from	to
<u>top soil</u>	<u>0</u>	<u>5</u>
<u>red clay</u>	<u>5</u>	<u>15</u>
<u>red sand</u>	<u>15</u>	<u>25</u>
<u>white sand</u>	<u>25</u>	<u>70</u>
<u>coarse sand</u>	<u>70</u>	<u>120</u>

WELL PURPOSE: Home
(home, irrigation, municipal, industrial)

- WELL COMPLETION DATA:
- (1) diameter (inches) 4
 - (2) total depth (feet) 120
 - (3) static water level (feet) 35 below top of ground.
 - (4) casing Plastic, 120,
(material) (depth)
(size) if telescope see back.
 - (5) screen 2.0 100,
(length) (depth to top)
3/4 Plastic
(size) (material)
 - (6) pump 3/4 15,
(HP) (yield gpm)
Elec.
(type power)
 - (7) electric log NO
(yes or no)
(organization running log)
 - (8) how well bottom plugged plugged

CODED


AUG 31 1970

DRILLERS REMARKS: good drilling

MISS. BD. OF
WATER COMMISSIONERS

If well telescopes please sketch and show depths.

GROUND LEVEL

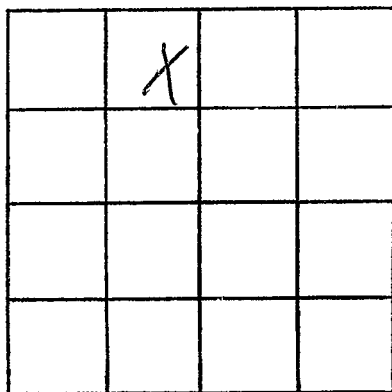

SECTION _____

Please indicate well location X.

ADDITIONAL INFORMATION

If more than one screen,
show locations of each on sketch.